


Section 29 Township 28 Range 1 E

Well No. # 3 Blood

Company Francis Raymond

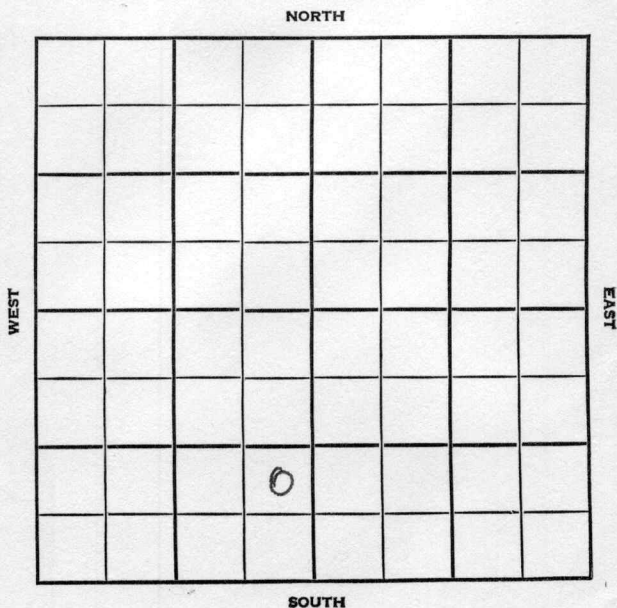

Sedgwick KANSAS

SEC.	TWP.	R.
29	28	1E

WELL NO. **3 Blood** FARM

COMPANY **Francis Raymond**

CONTRACTOR **Pabco**


**Glayds Pool**

\_\_\_\_\_ Ft. from N. Line

**990** \_\_\_\_\_ Ft. from S. Line

**330** \_\_\_\_\_ Ft. from E. Line

\_\_\_\_\_ Ft. from W. Line

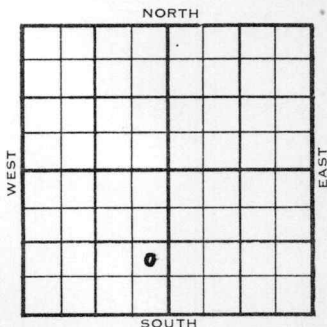

NE SE SW

1955	ELEVATION 1267'	REPORT
------	--------------------	--------

3/16  
4/27

Drlg. 3100'  
 Spud 3-8-55 - OilWell  
 TD 3200'  
 8" @ 152'  
 Stal. 2297', KC 2627', Cong 3128',  
 Miss. 3134', Miss dol 3144'  
 TD 3190'  
 5" @ 3189'  
 DD 3200', 1000A  
 F/40 boph 51/3145-50, 9/3152-55,  
 6/3166-68, 12/3169-73, 12/3174-78  
 40/3180-90, 3000A  
 Comp. F 1568 bopd

**COMPLETED**

County **Sedgwick** State **Kansas**

Sec. **29** (Blk. **28**) (Sur. **1E**) (Twp.) (Rge.) Map No.

Operator **Francis Raymond**

Well No. **3** Farm **Blood**

Elev. **1267** Location **NE SE SW**


**990** Ft. From **S** Line **SW**

**330** Ft. From **E** Line Quarter

1st. Report **MAR 16 1955**

Completion

Remarks

**Pabco - Contr.**

Spudding Date

**Gladys Pool**

Drlg. Data

**drlg. 3100**

FABEN GILSTRAP

