
Form 51 5M 8-24 16567

Map No. KANSAS Sec. 23 Twp. 23 R. 10

Well No. 26 Allen Farm

Mid Kansas Company

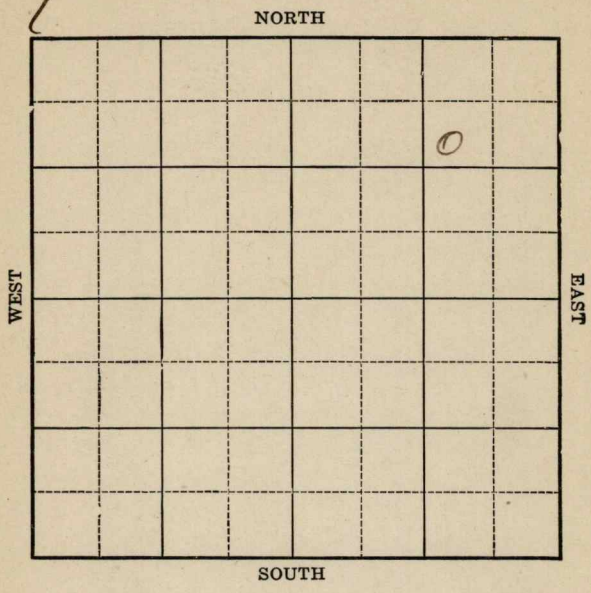

Location	Rig Up
Drilling Remarks	Drilling Remarks

Form 252A—5M—7-25—19684

Map No. Kans. Sec. 23 Twp. 23 R 10'

Well No. 26 Allen Farm


Mid-Kans Company

990' Ft. from N. Line

Ft. from S. Line

990' Ft. from E. Line

Ft. from W. Line

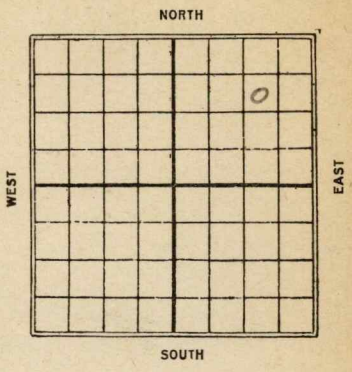

1925

Date,	REPORT
8/14	Location
8/20	timbers
8/26	Rig.
9/3	
9/11	320'
9/16	760'
9/24	1200'
10/1	Drlg 1500
10/8	D 1940
10/16	Top sand 2080-2102
	Btm. Sand 2102-2110
	Sand 2110-2123 T.D. 2133
	80 gt 125 Bbls

Form 26—1M Bks.—3-23—11959. Sherwood Co.

Map No. 16 KANSAS Sec. 23 Twp. 23 R. 10

Well No. 26 Allen

Mid-Kan Oil Co. Company

Contractor

FIRST REPORTS


990 Ft. from N. Line

Ft. from S. Line

990 Ft. from E. Line

Ft. from W. Line

SECTION PLAT

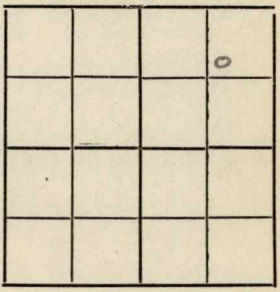

Location ✓

Rig up

Drilling and Remarks:

RECORD

Cased in., ft.

Sand

Gas

Oil

Total Depth

PRODUCTION

1st 24 hrs. Nat.

1st 24 hrs. after shot

Gas Cu. Ft.

Dry Hole

Abandoned

Date

AUG 14 1925

192

CHAS. L. SHERWOOD

Scout

Form 26—1M Bks.—3-23—11959. Sherwood & Co

K16 KANSAS Map No. _____ Sec. 23 Twp. 22 R. 10

Well No. 26 Allen

Mid-Kansas _____ Company

_____ Contractor

COMPLETED


990 Ft. from N. Line

_____ Ft. from S. Line

990 Ft. from E. Line

_____ Ft. from W. Line

SECTION PLAT

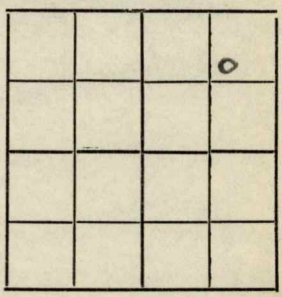

Location _____

Rig up _____

Drilling and Remarks:

Top Ad 2080- 2102'

Broken Ad 2102- 2110

Reno 2110- 2123'

T.D. 2133'

80/175 bbls.

RECORD

Cased _____ in., _____ ft.

Sand _____

Gas _____

Oil _____

Total Depth _____

PRODUCTION

1st 24 hrs. Nat. _____

1st 24 hrs. after shot _____

Gas _____ Cu. Ft.

Dry Hole _____

Abandoned _____

Date

OCT 16 1925

192 CHAS. L. SHERWOOD Scout