
Form 51 5M 7-22 9573

Map No. _____ Sec. 23 Twp. 23 R. 10

Well No. 3 Mason Farm

Mid-Kansas Company

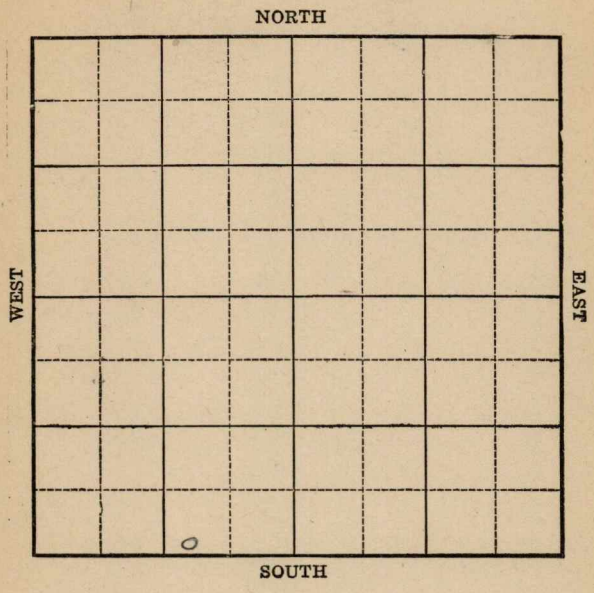

Location _____

Drilling Remarks:

Rig up _____

Drilling Remarks:

RECORD

Cased _____ in. _____ ft.

Sand _____

Gas _____

Oil _____

Total Depth _____

PRODUCTION

1st 24 hrs Nat. _____

1st 24 hrs. after shot _____

Gas _____ cu. ft.

Dry Hole _____

Abandoned _____

Form 252A 5M 4-22 8765

Map No. _____ Sec. 23 Twp. 23 R. 10

Well No. 3 Mason Farm


Mid-Kansas Company

_____ Ft. from N. Line

330 Ft. from S. Line

990 Ft. from E. Line

_____ Ft. from W. Line

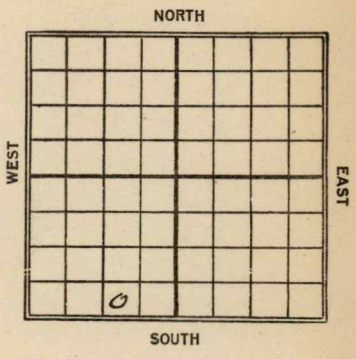

Date 1923	REPORT
8/7	Location
8/4	Sld 1870'
8/29	Sand 2272-2334, Plug back 2314' Shot 140 qts/40 Bbls

Form 26—1M—4-19—Mid-West

Map No. KANSAS Sec. 23 Twp. 23 R. 10


Well No. 3 Mason

Mid-Kansas Company

Contractor

FIRST REPORT

SECTION PLAT

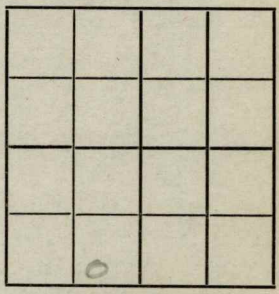

330 Ft. from N. Line

Ft. from S. Line

990 Ft. from E. Line

Ft. from W. Line

Location

Rig up

Drilling and Remarks:

RECORD

Cased in., ft.

Sand

Gas

Oil

Total Depth

PRODUCTION

1st 24 hrs. Nat.

1st 24 hrs. after shot

Gas Cu. Ft.

Dry Hole

Abandoned

Date MAY 7 1923

M. A. BENEAR

191 Scout

Form 26—1M Bks.—3-23—11959.

Map No. KANSAS 16 Sec. 23 Twp. 23 R. 10


Well No. 3 Mason

Mid-Kansas Company

Contractor

COMPLETED

SECTION PLAT

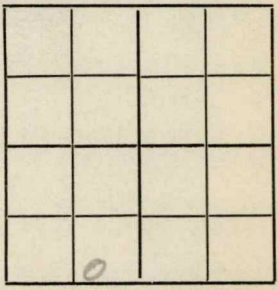

Ft. from N. Line

330 Ft. from S. Line

990 Ft. from E. Line

Ft. from W. Line

Location

Rig up

Drilling and Remarks:

sand 2272-2334
Rig tools 2314
140/140

RECORD

Cased in., ft.

Sand

Gas

Oil

Total Depth

PRODUCTION

1st 24 hrs. Nat.

1st 24 hrs. after shot

Gas Cu. Ft.

Dry Hole

Abandoned

Date

SEP 29 1923

192

M. A. BENEAR

Scout