
Form 51 5M 11-23 13896

Map No. 15 Sec. 23 Twp. 23 R. 10

Well No. 18 Allen Farm

Mid-Kansas Company

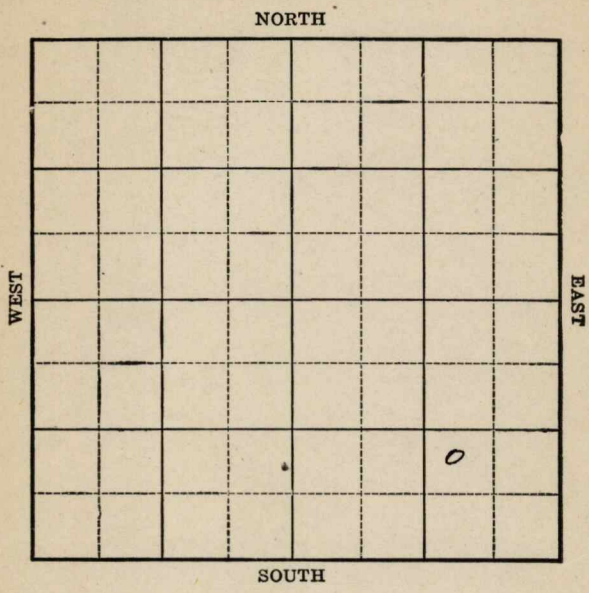

Location _____

Drilling Remarks:

Rig Up _____

Drilling Remarks:

RECORD

Cased _____ in. _____ ft.

Sand _____

Gas _____

Oil _____

Total Depth _____

PRODUCTION

1st 24 hrs. Nat. _____

1st 24 hrs. after shot _____

Gas _____ cu. ft.

Dry Hole _____


Abandoned _____

Form 252A 5M 4-22 8765

Map No. K Sec. 23 Twp. 23 R. 10

Well No. 18 Allen Farm

Mid-Kansas Company

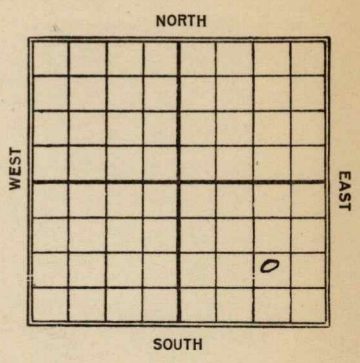

____ Ft. from N. Line

990 Ft. from S. Line

990 Ft. from E. Line

____ Ft. from W. Line

Date	REPORT
3/27	Rig up
4/24	Rig
5/22	Sand 2049–2104
	180/100 Bbls

Form 26—1M Bks.—3-23—11959.

Map No. KANSAS 16 Sec. 23 Twp. 23 R. 10


Well No. 18 - Allen

Mid-Kansas Company

_____ Contractor

FIRST REPORT

SECTION PLAT

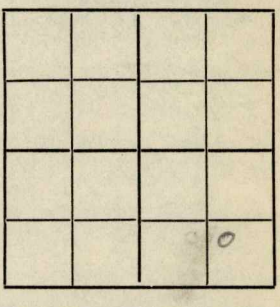

_____ Ft. from N. Line

990 Ft. from S. Line

990 Ft. from E. Line

_____ Ft. from W. Line

Location _____

Rig up _____

Drilling and Remarks:

RECORD

Cased _____ in., _____ ft.

Sand _____

Gas _____

Oil _____

Total Depth _____

PRODUCTION

1st 24 hrs. Nat. _____

1st 24 hrs. after shot _____

Gas _____ Cu. Ft.

Dry Hole _____

Abandoned _____

Date

FEB 27 1924

_____ 192___.

M. A. BENEAR

_____ Scout

Form 26—1M Bks.—3-23—11959.

16 KANSAS

Map No._____ Sec. 23 Twp. 33 R. 10


Well No. 18 A Allen

Mid-Kansas Company

_____ Contractor

COMPLETED

SECTION PLAT

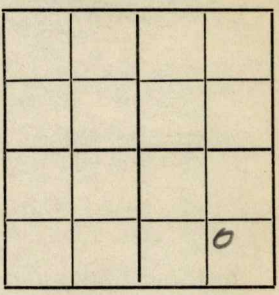

_____Ft. from N. Line

990 Ft. from S. Line

990 Ft. from E. Line

_____Ft. from W. Line

Location _____

Rig up _____

Drilling and Remarks:

Sand 2049-2116

180/100

RECORD

Cased _____ in., _____ ft.

Sand _____

Gas _____

Oil _____

Total Depth _____

PRODUCTION

1st 24 hrs. Nat. _____

1st 24 hrs. after shot _____

Gas _____ Cu. Ft.

Dry Hole _____

Abandoned _____

Date MAY 22 1924

M. A. BENEAR

_____192____ _____Scout