

Map No. 28 Sec. 28 Twp. 1E

Well No. 1- Blood Farm

Derby Oil Company

NORTH

WEST

EAST

Q							

SOUTH

Location.....

Drilling Remarks

Rig Up.....

Drilling Remarks

RECORD

Cased..... in..... ft.

Sand.....

Gas.....

Oil.....

Total Depth.....

PRODUCTION

1st 24 hrs. Nat.....

1st 24 hrs. after shot.....

Gas..... cu. ft.....

Dry Hole.....

Abandoned.....


Map No. KANSAS Sec. 28 Twp. 28 R. 1E
 Well No. 1-6300 Farm _____
Derby Oil Company

300 Ft. from N. Line

_____ Ft. from S. Line

_____ Ft. from E. Line

300 Ft. from W. Line

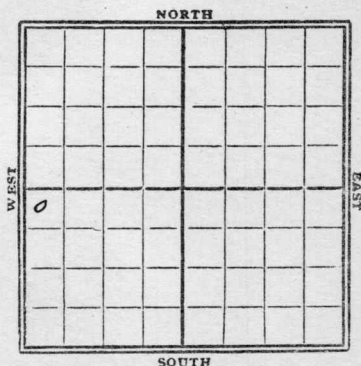

Date

REPORT

5/29 Root
 6/15 Bldg Rig
 6/12 Rynwup
 6/19 running dry pipe
 6/26 well 630'
 7/2 " 1250'
 7/10 " 1660'
 7/17 S/R 10" to 2000'
 7/24 Plg out 2005'
 7/31 well 2008'
 8/7 " 2365'
 8/14 8"-2725-UR.
 8/21 TAD 2771-UR 8"
 8/28 6"-3113 well 3134
 9/4 well 3355
 9/11 Wilcox 3592-98
 had HFW
 T.D. 3604
 Dry & Abandon

Map No. 12 KANSAS Sec. 28 Twp. 28 R. 1E

Well No. 1 Blood

Terby Oil Company

Contractor

SECTION PLAT

300 Ft. from N. Line

..... Ft. from S. Line

..... Ft. from E. Line

300 Ft. from W. Line

0			

FIRST REPORTS

Location.....

Rig up.....

Drilling and Remarks:

ROG

RECORD

Cased.....in.,ft.

Sand.....

Gas.....

Oil.....

Total Depth.....

PRODUCTION

1st 24 hrs. Nat.....

1st 24 hrs. after shot.....

Gas.....Cu. Ft.

Dry Hole.....

Abandoned.....

Date

MAY 29 1929

192

S. J. LEWIS

Scout

Map No. KANSAS Sec. 28 Twp. 28 R. 1E

Well No. 1 Blood

Terry Oil Company

Contractor


SECTION PLAT

300 Ft. from N. Line

..... Ft. from S. Line

..... Ft. from E. Line

300 Ft. from W. Line

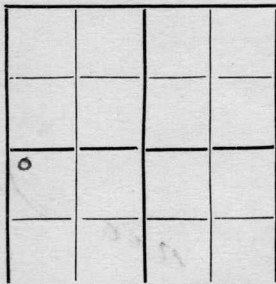

ABANDONED

Location.....

Rig up.....

Drilling and Remarks:

Shicox 3092-98

ATW

RECORD

Cased.....in.,ft.

Sand.....

Gas.....

Oil.....

Total Depth 3604

PRODUCTION

1st 24 hrs. Nat.....

1st 24 hrs. after shot.....

Gas.....Cu. Ft.

Dry Hole.....

Abandoned.....

Date

SEP 11 1928

S. J. LEWIS

Scout