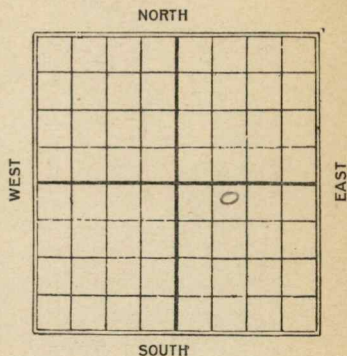


Map No. Kansas Sec. 23 Twp. 23 R. 10Well No. 22 Allen FarmMid-Kansas Company330 Ft. from N. Line

Ft. from S. Line

Ft. from E. Line

990 Ft. from W. Line

C

Date	REPORT
1925	
4/24	Location
5/29	Sly 1200
6/5	✓ 1700
6/12	✓ 2050
6/19	5 2068-2117' shot 30 ft - shot went off 300' from top. skid rig 20' south
6/26	New hole Dily. 150
7/3	750'
7/10	1000'
7/17	1400
7/24	1800'
7/31	Tap at 2064 - 2114' 70 100y 130 b/s

Map No. 6 Kh 24 Sec. 23 Twp. 23 R. 10Well No. 22 AllenMid-Kh 24 Company

Contractor

FIRST REPORTS

SECTION PLAT

330 Ft. from N. Line

Ft. from S. Line

Ft. from E. Line

990 Ft. from W. Line

Location ✓

Rig up

Drilling and Remarks:

RECORD

Cased _____ in., _____ ft.

Sand _____

Gas _____

Oil _____

Total Depth _____

PRODUCTION

1st 24 hrs. Nat. _____

1st 24 hrs. after shot _____

Gas _____ Cu. Ft.

Dry Hole _____

Abandoned _____

Date

APR 24 1925

192

Chs. L. Sheward Scout


Contractor

COMPLETED

SECTION PLAT

330 Ft. from N. Line

Ft. from S. Line

Ft. from E. Line

990 Ft. from W. Line

		o	

Location

Rig up

Drilling and Remarks:

RECORD

Cased 2064 in., 2114 ft.

Sand

Gas

Oil

Total Depth 2114

PRODUCTION

1st 24 hrs. Nat.

1st 24 hrs. after shot

Gas Cu. Ft.

Dry Hole

Abandoned

Date

JUL 31 1925

192

CHAS. L. SHERWOOD

Scout