
Form 51 5M 8-24 16567

Map No. Kan Sec. 23 Twp. 23 R. 10 ✓

Well No. 24 Allen Farm

Mid-Kansas Company

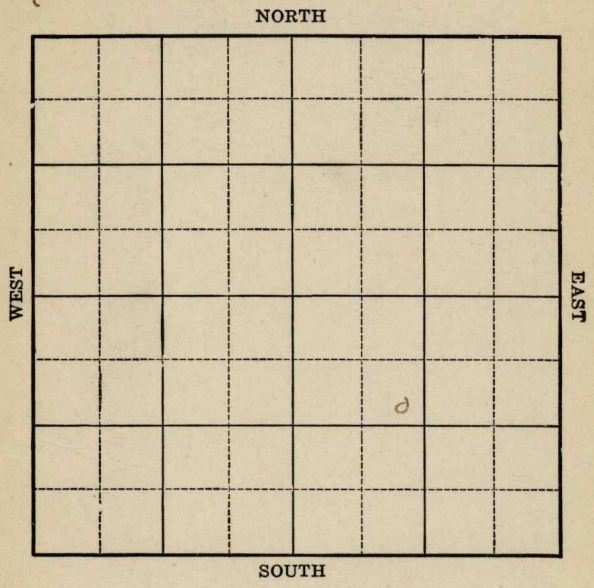

Location

Drilling Remarks

Rig Up

Drilling Remarks

RECORD

Cased in. ft.

Sand

Gas

Oil

Total Depth

PRODUCTION

1st 24 hrs. Nat.

1st. 24 hrs. after shot

Gas cu. ft.

Dry Hole

Abandoned

Form 252A 5M 8-24 16529

Map No Kan Sec. 23 Twp. 33 R 10

Well No. 24 Allen Farm

Mid Kansas Company


1120 Ft. from N. Line

Ft. from S. Line

Ft. from E. Line

1120 Ft. from W. Line

C

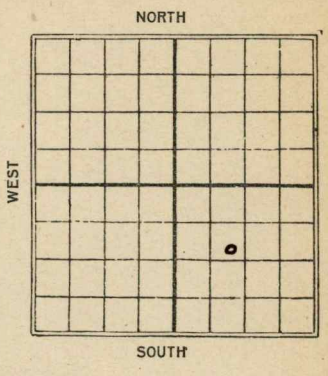

Date 1925	REPORT
7/3	Location
7/10	Rig
7/17	Spud
7/24	D 350'
7/31	600
8/7	1150'
8/14	1450'
8/20	1850'
8/26	Tag s. 2024 shale break 2024–29' sand 2029–68 Pay 2068–2112 shot 100/175 lbs.

Form 26—1M Bks.—3-23—11959.

Map No. 16 Kendall Sec. 23 Twp. 23 R. 10

Well No. 24 Allen

Mid-Kansas Company

Contractor

FIRST REPORTS


1120 Ft. from N. Line

Ft. from S. Line

Ft. from E. Line

1120 Ft. from W. Line

SECTION PLAT

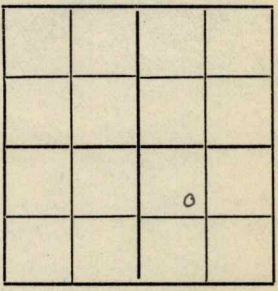

Location ✓

Rig up

Drilling and Remarks:

RECORD

Cased in., ft.

Sand

Gas

Oil

Total Depth

PRODUCTION

1st 24 hrs. Nat.

1st 24 hrs. after shot

Gas Cu. Ft.

Dry Hole

Abandoned

Date

JUL 3 1925

192

CHAS. L. SHERWOOD

Scout

Form 26—1M Bks.—3-23—11959. Sherwood C6

Map No. 11e KANSAS Sec. 22 Twp. 22 R. 10

Well No. 24 Allen

Mid-Kansas Company

Contractor

COMPLETED


1120 Ft. from N. Line

Ft. from S. Line

Ft. from E. Line

1120 Ft. from W. Line

SECTION PLAT

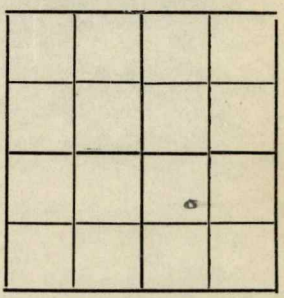

Location

Rig up

Drilling and Remarks:

Top Rd 2024'
Phab Blds 2024-29'
Blnd 2029-68'
Pay 2068-2112'
100/175 bbls

RECORD

Cased in., ft.

Sand

Gas

Oil

Total Depth 2112'

PRODUCTION

1st 24 hrs. Nat.

1st 24 hrs. after shot

Gas Cu. Ft.

Dry Hole

Abandoned

Date

AUG 27 1925

192

CHAS. L. SHERWOOD

Scout