
Form 51 5M 8-24 16567

Map No. ____ Sec. 23 Twp. 23 R. 10

Well No. 25 Allen Farm

Mid-Kansas Company

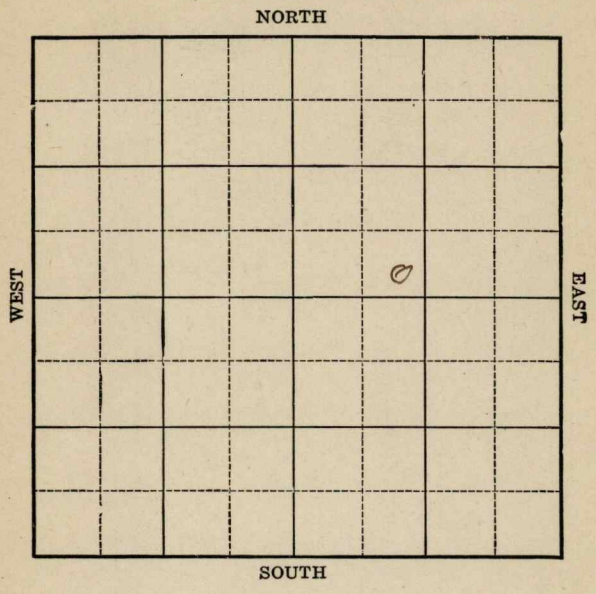


Location ____

Drilling Remarks

Rig Up ____

Drilling Remarks

RECORD

Cased ____ in. ____ ft.

Sand ____

Gas ____

Oil ____

Total Depth ____

PRODUCTION

1st 24 hrs. Nat. ____

1st. 24 hrs. after shot ____

Gas ____ cu. ft.

Dry Hole ____


Abandoned ____

Form 252A 5M 8-24 16529

Map No. Kan Sec. 23 Twp. 23 R 10 E

Well No. 25 Allen Farm

Mid - Kansas Company

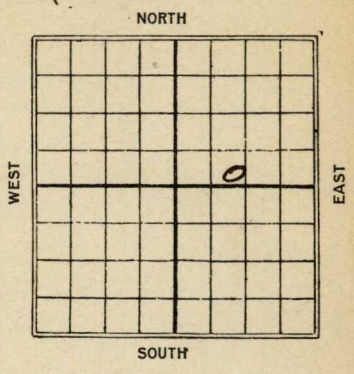


Ft. from N. Line

250' Ft. from S. Line

Ft. from E. Line

1020' Ft. from W. Line

| 1925 | REPORT |
|---|---|
| 7/24 | Loc. |
| 7/31 | — |
| 8/7 | — |
| 8/14 | Rig. |
| 8/20 | 320 |
| 8/26 | 800' |
| 9/3 | 1200 |
| 9/11 | 1900 |
| 9/16 | Top sand 2076' 1st oil 2098' |
| 9/24 | TD. 2122+400' oil in hole |
| 9/25 | Sand 2076-2122 |
| | 100 qts 50 Bbls |

Form 26—1M Bks.—3-23—11959.

Map No. Kinkaid Sec. 23 Twp. 22 R. 10


Well No. 25 Allen

Mid-Kinkaid Company

Contractor

FIRST REPORTS

SECTION PLAT

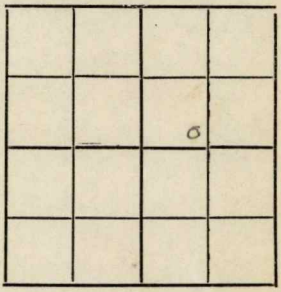

Ft. from N. Line

2520 Ft. from S. Line

Ft. from E. Line

1020 Ft. from W. Line

Location

Rig up

Drilling and Remarks:

**RECORD**

Cased in., ft.

Sand

Gas

Oil

Total Depth

**PRODUCTION**

1st 24 hrs. Nat.

1st 24 hrs. after shot

Gas Cu. Ft.

Dry Hole

Abandoned

Date

JUL 24 1925 192

CHAS. L. SHERWOOD Scout

Form 26—1M Bks.—3-23—11959. Allen wood #6

Map No. KANSAS Sec. 23 Twp. 23 R. 10

Well No. 25 Allen

Mid-Kan Dr Company

Contractor

## COMPLETED


Ft. from N. Line

250 Ft. from S. Line

Ft. from E. Line

1020 Ft. from W. Line

## SECTION PLAT

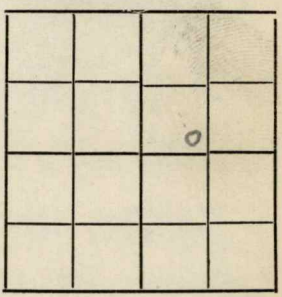


Location

Rig up

Drilling and Remarks:

1st oil 2098'

100/50 bbls.

## RECORD

Cased in., ft.

Sand 2076 2122

Gas

Oil

Total Depth 2122'

## PRODUCTION

1st 24 hrs. Nat.

1st 24 hrs. after shot

Gas Cu. Ft.

Dry Hole

Abandoned

Date

SEP 25 1925

192

CHAS. L. SHERWOOD Scout