


Section 29 Township 28 Range 1E
 Well No. #5 Blood
 Company Francis Raymond

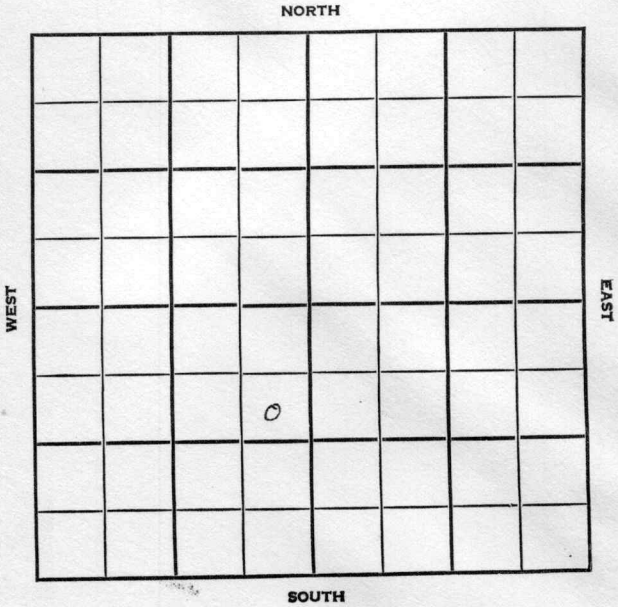

SEC.	TWP.	R.
29	28	1E

WELL NO.

5 Blood

FARM

COMPANY

Francis Raymond

CONTRACTOR

Murfin

Gladys Pool

990

Ft. from N. Line


Ft. from S. Line

300

Ft. from E. Line

Ft. from W. Line

SE NE SW

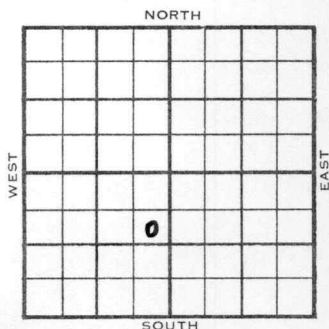

1955

ELEVATION

REPORT

4/6	Spud 4-3-55 8" @ 158' Drlg. 188'		
6/8	5½" @ 3185-75 DD 3200 HFO 18/3178-84 1000 A 45/3154-69, 42/3132-46, 250A 1000 A F/80 boph 4 hr. Comp. F/1573 bopd.		
	Tops:	Depth	Datum
	H. Stal	2295	1022
	KC	2627	1354
	M. doño	3132	1859
	TD	3185	

COMPLETED

County Sedgwick State Kansas
 Sec. 29 (Blk.) 28 (Sur.) 1E Map No.
 Operator Francis Raymond
 Well No. 5 Farm Blood
 Elev. _____ Location SE NE SW

FIRST REPORT

990 Ft. From N Line SW
330 Ft. From E Line Quarter
 1st. Report APR 6 1955
 Completion _____
 Remarks _____
Murfin Drlg. - Contr.
 Spudding Date 4-3-55

Drlg. Data Gladys Pool
8" @ 158 drlg. 188

FABEN GILSTRAP

County Sedgwick Elev. 1273
 Sec. 29 Twp. 128 Rge. 1E
 Company Francis Raymond
 Farm Name Blood No. 5

TOPS	DEPTH	LOG	DATUM
Anh.			
T.P.			
H. <u>Stal.</u>	<u>2295</u>		<u>1022</u>
Tr.			
Dg.			
B.L.			
L.			
K.C.	<u>2627</u>		<u>1354</u>
B.K.C.			
Ce.			
C.			
M. <u>Dole</u>	<u>3132</u>		<u>1859</u>
M.			
K.			
Mz.			
Mq.			
V.			
S.			
S.			
A			
R.			
Pe.			
G.			
T.D.	<u>3185</u>		

Loc. in Sec. SE NE SWGeol. MurfinContr. GladysPool COMPLETE

JUN 8 1955

Date Comm. 4-3-558" @ 158/123 5 $\frac{1}{2}$ " @ 3185-75 DD 3200

HFO 18/ 3178-84 1000 A 45/ 3154-69

42/ 3132-46 250 A 1000 A

F/ 80 boph 4 hr. Comp. F/ 1573 bopd