
DX 78-1

Sedgwick County, Kansas

Section 29 Township 28S Range 1E

Well No. #8 Blood

Company Francis Raymond

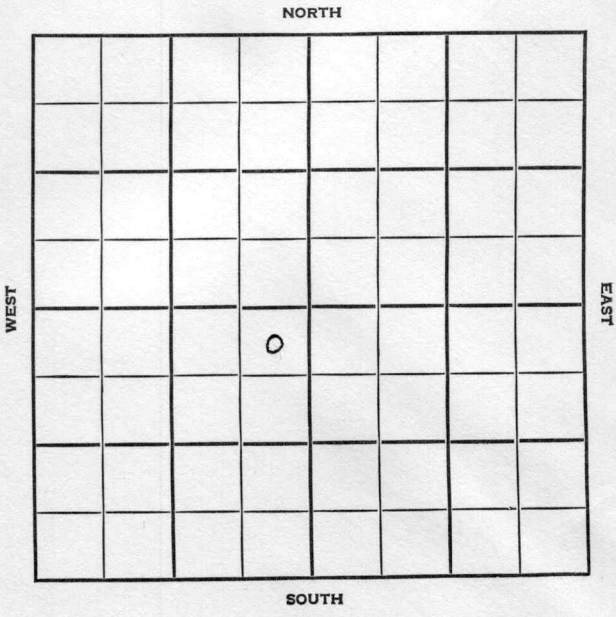

Sedgwick KANSAS

SEC.	TWP.	R.
29	28	1E

WELL NO.

#8 Blood FARM

COMPANY

Francis Raymond

CONTRACTOR

Murfin

Gladys


_____ Ft. from N. Line

_____ Ft. from S. Line

_____ Ft. from E. Line

_____ Ft. from W. Line

NE NE SW

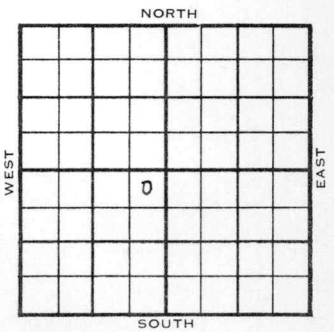

1955	ELEVATION 1272'	REPORT

9-14 Comm. 9-7-55
8" @ 158/160
Drlg. 2520'

11/2 Comm 9-7-55
8" @ 158/160
5 1/2" @ 3201
Stal 2281
KC 2619
Dolo 3131
TD 3201
CO 20/3134-39 40/~~3201~~ 3146-56 24/
3164-70 12/3174-77 F/40 BOR 10 hr
Comp F/564 bopd

COMPLETED

DX-78

FORM 513 REV. SUNRAY

County Sedgwick Elev.

Sec. 29 Twp. 28 Rge. 1E

Company Francis Raymond

Farm Name Blood No. 8

TOPS	DEPTH	LOG	DATUM
Anh.			
Tp.			
H.			
Tr.			
Dg.			
B.L.			
L.			
K.C.			
B.K.C.			
Ce.			
C.			
M.			
M.			
K.			
Mz.			
Mq.			
V.			
S.			
S.			
A			
R.			
P€.			
G.			
T.D.			

Loc. in Sec. NE NE SW

Geol.

Contr. Murfin

Pool Gladys

FIRST REPORT

SEP 14 '55

Date Comm. 9-7-55

8" @ 158/160 dr lg. 2520

Co. Lse. No. Sec. T. R.

FORM 513 REV. SUNRAY

County Sedgwick Elev. 1272

Sec. 29 Twp. 28 Rge. 1E

Company Francis Raymond

Farm Name Blood No. 8

TOPS	DEPTH	LOG	DATUM
Anh. Stark	2281		1009
Tp.			
H.			
Tr.			
Dg.			
B.L.			
L.			
K.C.	2619		1347
B.K.C.			
Ce.			
C.			
M. dolo	3131		1859
M.			
K.			
Mz.			
Mq.			
V.			
S.			
S.			
A			
R.			
P€.			
G.			
T.D.	3201		

Loc. in Sec. NE NE SW

Geol.

Contr. Murfin

Pool Gladys

COMPLETE

0

Date Comm. 9-7-55 NOV 2 1955

8" @ 158/160 5½" @ 3201 CO

20/ 3134-39 40/ 3146-56 24/ 3164-70

12/ 3174-77 F/ 40 bo 10 hr.

Comp. F/ 564 bopd

Co. Lse. No. Sec. T. R.