
FORM 51 25M 8-50 WESTERN Greenwood

Section 23 Township 23 Range 10E

Well No. #1 Norton

Company L. K. Jones

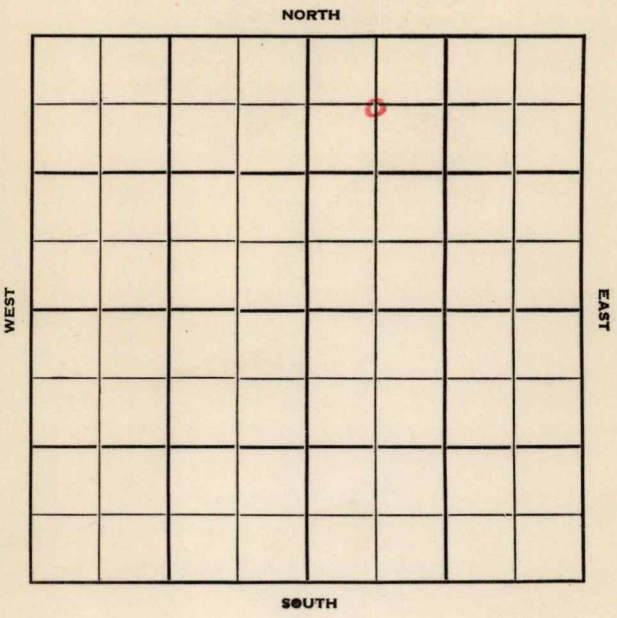

FORM 252-B
10M 10-50 PETROL

Greenwood

KANSAS

Sec. 23 Twp. 23 R. 10E ✓

Well No. #1 Norton Farm

L. K. Jones Company

Contractor

Burkett Pool


660 Ft. from N. Line

Ft. from S. Line

Ft. from E. Line

660 Ft. from W. Line

C NW NE

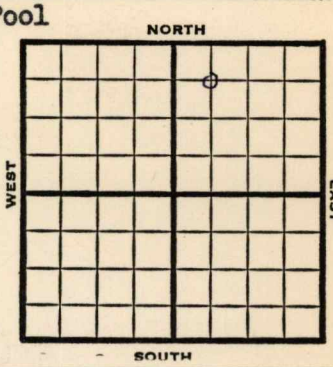

1952	-	REPORT
1/2	D&A TD 2116 Bart. 2084 5" @2084 TD 2116' D&A	

FIRST REPORT

ABANDONED

FORM 275 FOR SALE BY KANSAS BLUE PRINT CO.


County Greenwood State Kansas

Sec. 23 (Blk. Twp.) 23 (Sur. Rge.) 10E Map No.

Operator L. K. Jones

Well No. 1 Farm Norton

Elev. Location C NW NE

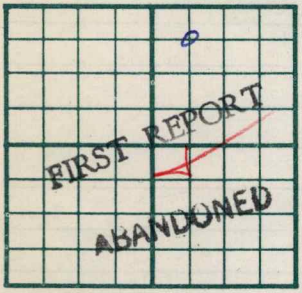

660 Ft. From N Line NE

660 Ft. From W Line Quarter

1st. Report JAN 2 1952

Completion JAN 2 1952

Remarks

Spudding Date

Drlg. Data D & A TD 2116 Burkett Pool

Bart. 2084 5" @ 2084 TD 2116

D & A

J. E. TYRA