
DX 78-1

Sedgwick KANSAS

Section 29 Township 28 Range 1 E

Well No. # 1 Boren

Company Petroleum Inc.

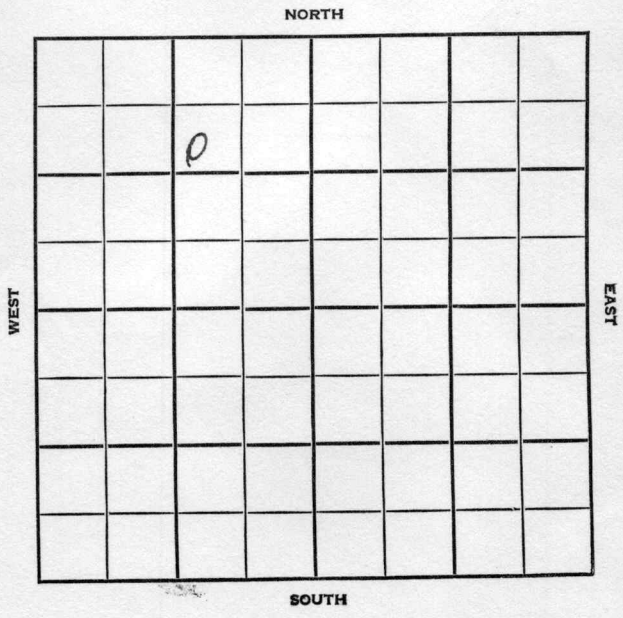

Sedgwick KANSAS

SEC.	TWP.	R.
29	28	1 E

WELL NO.

1 Boren FARM

COMPANY

Petroleum Inc.

CONTRACTOR

Schafer

Gladys Pool


1155 Ft. from N. Line

Ft. from S. Line

1155 Ft. from E. Line

Ft. from W. Line

SW SW NE NW

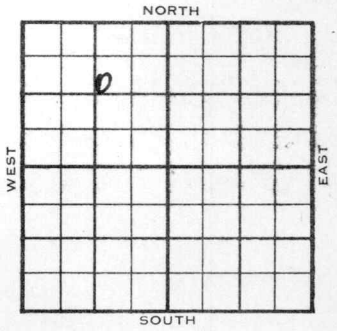

1955

ELEVATION 1270'

REPORT

2/23 RUR

3/9 pud 2-21-55 - D&A
TD 3314'
8" @ 148'
KC 2617'
DST 2719-2802', misrun
DST 2719-2802', opn 1 hr., rec. 80' mud, 1015#
Miss. 3143'
DST 3146-3314', opn 1 hr., rec. 720' mud, 800#
TD 3314'
D&A

ABANDONED

DX-78

FORM 275 FOR SALE BY KANSAS BLUE PRINT CO.


County Sedgwick State Kansas

Sec. 29 (Blk. Twp.) 28 (Sur. Rge.) 1E Map No.

Operator Petroleum Inc.

Well No. 1 Farm Boren

Elev. Location SW SW NE NW

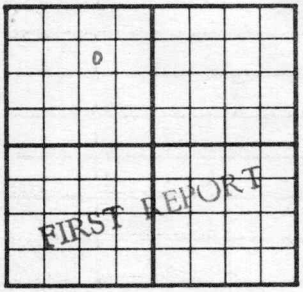

1155 Ft. From N Line NW

1155 Ft. From E Line Quarter

1st. Report FEB 2 3 1955

Completion

Remarks Schafer - Contr.

Spudding Date Gladys Pool

Drlg. Data R U R

FABEN GILSTRAP

FORM 275 FOR SALE BY KANSAS BLUE PRINT CO.

County Sedgwick State Kansas

Sec. 29 (Blk. Twp.) 28 (Sur. Rge.) 1 E Map No.

Operator Petroleum Inc.

Well No. 1 Farm Boren

Elev. 1270 Location SW SW NE NW



1155 Ft. From N Line NW

1155 Ft. From E Line Quarter

1st. Report

Completion MAR 9 1955

Remarks Gladys Pool

Schafer - Contr.

Spudding Date 2-21-55

Drlg. Data D & A TD 3314

8" @ 148 KC 2617 DST 2719-2802

misrun DST 2719-2802 open 1 hr. Rec.

80' mud 1015# Miss. 3143 DST 3146-

3314 open 1 hr. Rec. 720' mud 800#

TD 3314

D & A

FABEN GILSTRAP