


Section 29 Township 28 Range 1EWell No. 1 Bowmaker UnitCompany Petroleum Inc.

NORTH

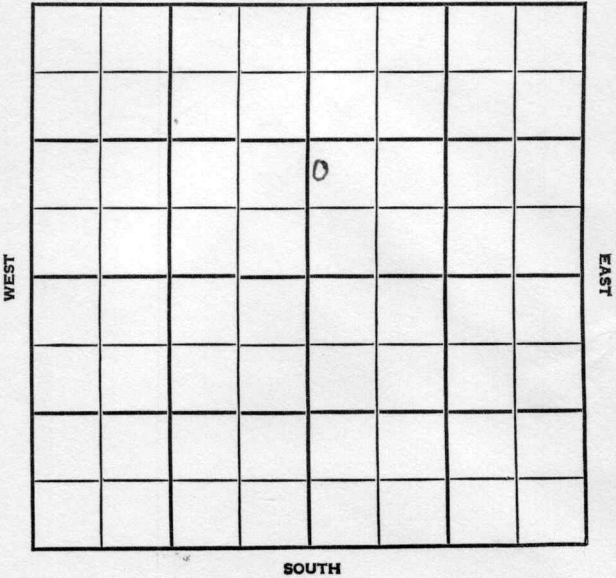

SOUTH

Sedgwick

SEC.	TWP.	R.
29	28S	1E

WELL NO.

#1 Bowmaker Unit

FARM

COMPANY

Petroleum Inc.

CONTRACTOR

Rig #14 Garvey

DS-2 Acres Gladys

Ft. from N. Line

990'


Ft. from S. Line

Ft. from E. Line

237

Ft. from W. Line

NW SW NE

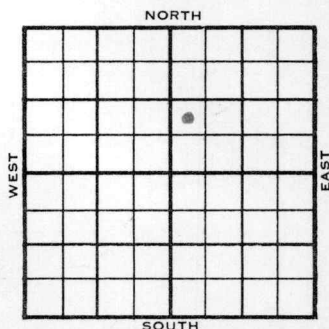

1955

ELEVATION

1272'

REPORT

7/20

MIRT

9-14

Comm. 7-19-55

8 5/8" @ 146/175

DST 3134-51 open 1 hr., rec 160' froggy oil 90' wtr.

5" @ 3173 40/ 3140-50 2000 A

F/ 17 bo 1 1/2 hr. .87 bfph 47% wtr.

1.28 bfph 61% wtr.

Temp. abd.

Tops: K.C. 2611

Lm 3128

Dolo 3133

T.D. 3175'

ABANDONED

County **Sedgwick** Elev. _____ Co.
 Sec. **29** Twp. **288** Rge. **1E**
 Company **Petroleum Inc.**
 FarmName **Bowmaker Unit** No. **1**

TOPS	DEPTH	LOG	DATUM
Anh.			
TP.			
H.			
Tr.			
Dg.			
BL.			
L.			
K.C.			
B.K.C.			
Ce.			
C.			
M.			
M.			
K.			
Mz.			
Mq.			
V.			
S.			
S.			
A.			
R.			
PE.			
G.			
T.D.			

Loc. in Sec. _____

NW SW NE

237' FWL x

990' FSL NE/4

Geol. _____

Contr. Rig #14

Garvey

Pool DS-2 acres

Gladys

JUL 20 '55
 FIRST REPORT

Date Comm. **MIRT**

No.

Sec.

T.

R.

County Sedgwick Elev. 1272 Co. 28
 Sec. 29 Twp. 28 Rge. 1E
 Company Petroleum Inc.
 Farm Name Bowmaker Unit No. 1

TOPS	DEPTH	LOG	DATUM	Loc. in Sec.
Anh.				NW SW NE
Tp.				
H.				
Tr.				990' SL
Dg.				237' WL
Bl.				
L.				
K.C.	2611		1339	Geol.
B.K.C.				Contr.
Ce.				Garvey
C.				
M. <u>Lm</u>	3128		1856	Pool
M. <u>Do/o</u>	3133		1861	Gladys
K.				
Mz.				
Mq.				
V.				
S.				
S.				
A.				
R.				
Pe.				
G.				
TD.	3175			

SEP 14 1955

Date Comm. 7-19-55
8 5/8" @ 146/175 DST 3134-51 open 1 hr.
Rec. 160' froggy oil 90' wtr. TD 3175
5" @ 3173 40/ 3140-50 2000 A
F/ 17 bo 1 1/2 hr. .87 bfph 47% wtr.
1.28 bfph 61% wtr. Temp. abd.

