DX 78-1


KANSAS

Sedgwick

Section 29 Township 28 Range 1E

Well No. #1 Boyce Unit

Company Adair Oil

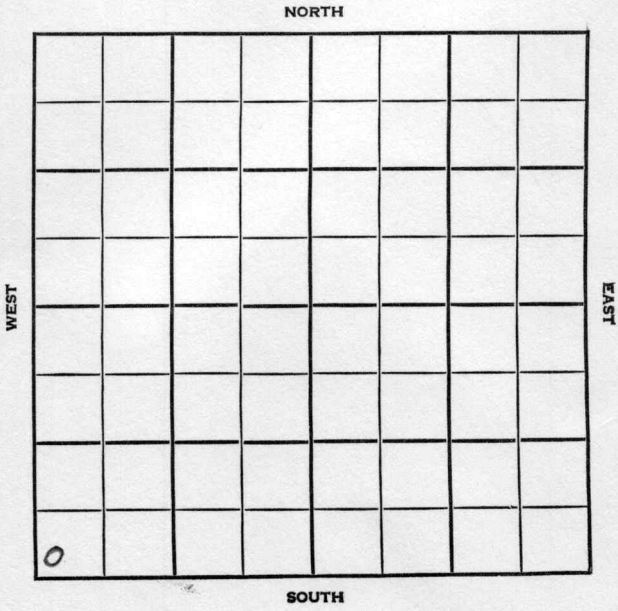

Sedgwick KANSAS

SEC.	TWP.	R.
29	28	1 E

WELL NO.

1 Boyce Unit FARM

COMPANY

Adair Oil

CONTRACTOR

Co. tools

Gladys


_____ Ft. from N. Line

200 Ft. from S. Line

_____ Ft. from E. Line

480 Ft. from W. Line

SW SW SW

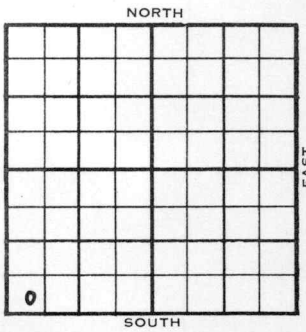

1955	ELEVATION 1265'	REPORT

6/8 Comm. 5-31-55
8" @ 163/135
Drlg. 2845'

7/7 5½" @ 3157/100 CO to 3197 3000A F/60 bopd, Comp. F/321 bopd.

Tosp:	Depth	Datum
KC.	2633	1368
BKC.	2832	1567
M. Lm	3145	1880
M. dolo	3155	1890
TD.	3197	

COMPLETED

DX-78

FORM 513 REV. SUNRAY

County Sedgwick Elev. 1265

Sec. 29 Twp. 28 Rge. 1E

Company Adair Oil

Farm Name Boyce Unit No. 1

TOPS	DEPTH	LOG	DATUM
Anh.			
T.P.			
H.			
Tr.			
Dg.			
B.L.			
L.			
K.C.			
B.K.C.			
Ce.			
C.			
M.			
M.			
K.			
Mz.			
Mo.			
V.			
S.			
S.			
A			
R.			
P€.			
G.			
T.D.			

Loc. in Sec. SW SW SW

200' SL

480' WL

Geol.

Contr. Co. tools

Pool Gladys

FIRST REPORT

JUN 8 '55

Date Comm. 5-31-55

8" @ 163/135 drlg. 2845

Co. Lse. No. Sec. T. R.

FORM 513 REV. SUNRAY

County Sedgwick Elev. 1265

Sec. 29 Twp. 28 Rge. 1E

Company Adair Oil

Farm Name Boyce Unit No. 1

TOPS	DEPTH	LOG	DATUM
Anh.			
T.P.			
H.			
Tr.			
Dg.			
B.L.			
L.			
K.C.	2633		1368
B.K.C.	2832		1567
Ce.			
C.			
M. Lm	3145		1880
M. Dolo	3155		1890
K.			
Mz.			
Mo.			
V.			
S.			
S.			
A			
R.			
P€.			
G.			
T.D.	3197		

Loc. in Sec. SW SW SW

200' SL

480' WL

Geol.

Contr. Co. tools

Pool Gladys

COMPLETE

Date Comm. 5-31-55

JUL 6 1955

8" @ 163/135 5½" @ 3157/100

CO to 3197 3000 A F/ 60 boph

Comp. F/ 321 bopd

Co. Lse. No. Sec. T. R.