


Map No. K Sec. 23 Twp. 23 R. 40Well No. 3 Scott FarmRoth Etal Company

NORTH

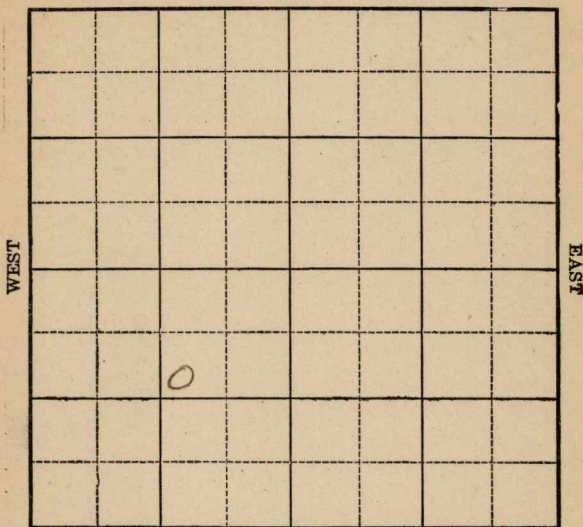

SOUTH

Location _____

Rig up _____

Drilling Remarks:

Drilling Remarks:

RECORD

PRODUCTION

Cased _____ in. _____ ft.

1st 24 hrs Nat. _____

Sand _____

1st 24 hrs. after shot _____

Gas _____

Gas _____ cu. ft.

Oil _____

Dry Hole _____

Total Depth _____

Abandoned _____

Map No. **KANSAS** ¹⁶ Sec. 23 Twp. 23 R. 10
Well No. 3 Scott
Roth & et al Company
Contractor

FIRST REPORT

SECTION PLAT

1120 Ft. from N. Line
Ft. from S. Line
1120 Ft. from E. Line
Ft. from W. Line

Location _____
Rig up _____
Drilling and Remarks:

spud

RECORD

Cased _____ in., _____ ft.
Sand _____
Gas _____
Oil _____
Total Depth _____

PRODUCTION

1st 24 hrs. Nat. _____
1st 24 hrs. after shot _____
Gas _____ Cu. Ft.
Dry Hole _____
Abandoned _____

Map No. **16** **KANSAS** Sec. **23** Twp. **23** R. **10E**

Well No. **3 south**
Rath et al

Company

Contractor

ABANDONED SECTION PLAT

1120 Ft. from N. Line
Ft. from S. Line
1120 Ft. from E. Line
Ft. from W. Line

Location

Rig up

Drilling and Remarks:

Levd
2050 am
act of
fishing job.

RECORD

Cased in., ft.
Sand
Gas
Oil
Total Depth

PRODUCTION

1st 24 hrs. Nat.
1st 24 hrs. after shot
Gas Cu. Ft.
Dry Hole
Abandoned

Date
NOV 28 1924

M. A. BENEAR

192 Scout