
Form 51 5M 8-24 16567

Map No. Kansas Sec. 23 Twp. 23 R. 10

Well No. 4 Scott Farm

Rock + Mission Company

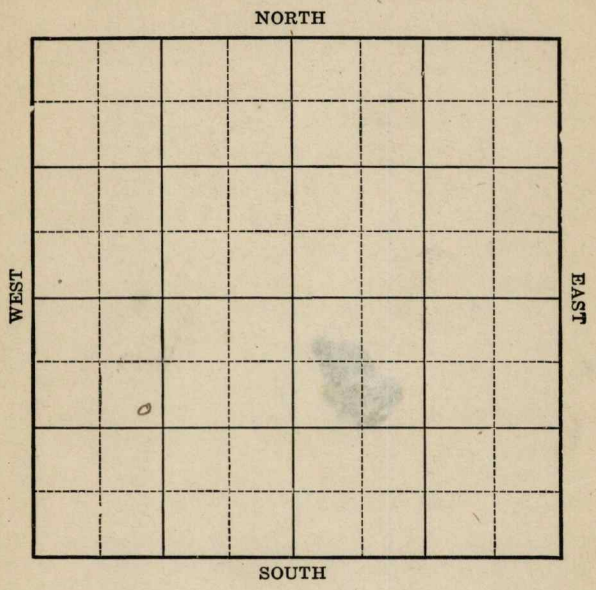

Location

Drilling Remarks

Rig Up

Drilling Remarks

RECORD

Cased in. ft.

Sand

Gas

Oil

Total Depth

PRODUCTION

1st 24 hrs. Nat.

1st. 24 hrs. after shot

Gas cu. ft.

Dry Hole

Abandoned

Form 252A 5M 8-24 16529

Map No. Kaw Sec. 23 Twp. 23 R 10

Well No. 4 Scott Farm


Roth & Mission Company

1020 Ft. from N. Line

Ft. from S. Line

Ft. from E. Line

1020 Ft. from W. Line

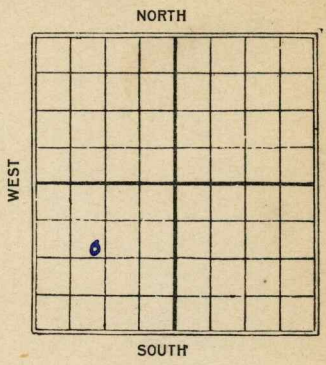

C

Date 1922	REPORT
6/12	Location
6/19	
6/26	
7/3	F 2102 Bk. sd. 2102-12 dry sd 2112-37 oil 2137-65 shale 2165-77 T.D. will shoot
7/10	
7/17	2102-65 - T.D. 2177 8 5/8 11

Form 26—1M Bks.—3-23—11959.

Map No. 6 Sec. 23 Twp. 22 R. 10

Well No. 4 Scott

Roth & Mission Company

Contractor

1020 Ft. from N. Line


Ft. from S. Line

Ft. from E. Line

1020 Ft. from W. Line

FIRST REPORTS

SECTION PLAT

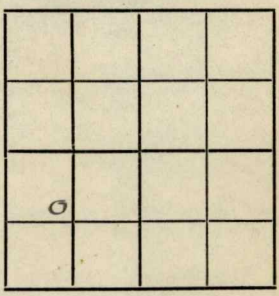

Location ✓

Rig up

Drilling and Remarks:

RECORD

Cased in., ft.

Sand

Gas

Oil

Total Depth

PRODUCTION

1st 24 hrs. Nat.

1st 24 hrs. after shot

Gas Cu. Ft.

Dry Hole

Abandoned

Date

JUN 12 1925

192

CHAS. L. SHERWOOD

Scout

Form 26—1M. Bks.—3-23—11959.

Map No. W. Banks Sec. 33 Twp. 23 R. 10

Well No. 4 Scott

Roth & Mission Company

Contractor

COMPLETION


1020 Ft. from N. Line

Ft. from S. Line

Ft. from E. Line

1020 Ft. from W. Line

SECTION PLAT

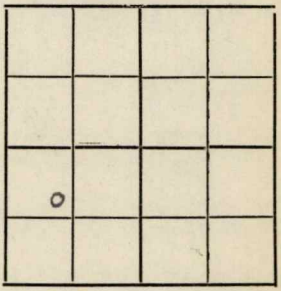

Location

Rig up

Drilling and Remarks:

1st on 2137

80/15 b/s

RECORD

Cased in., ft.

Sand 2102-65

Gas

Oil

Total Depth 2177

PRODUCTION

1st 24 hrs. Nat.

1st 24 hrs. after shot

Gas Cu. Ft.

Dry Hole

Abandoned

Date

JUL 17 1925

192

CHAS. L. SHERWOOD

Scout