


Map No. Kansas Sec. 10 Twp. 23 R. 13
 Well No. 20 Schneider Farm
Theta oil Co. Company

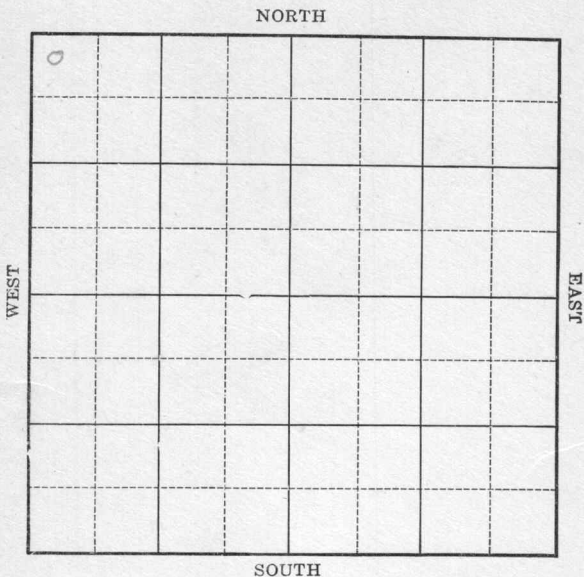

Location _____

Drilling Remarks _____

Rig Up _____

Drilling Remarks _____

RECORD

Cased _____ in. _____ ft.

Sand _____

Gas _____

Oil _____

Total Depth _____

PRODUCTION

1st 24 hrs. Nat. _____

1st 24 hrs. after shot _____

Gas _____ cu. ft.

Dry Hole _____


Abandoned _____

Greenwood Co

Map No. Kansas Sec. 10 Twp. 23 R. 13Well No. 20 Schrader Farm
Theta Oil Company200 Ft. from N. Line

_____ Ft. from S. Line

_____ Ft. from E. Line

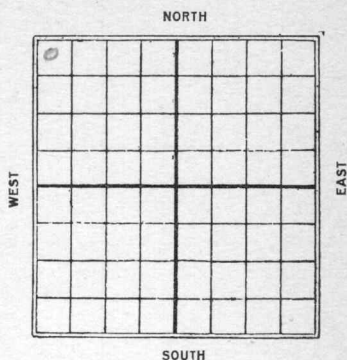200 Ft. from W. Line

Date

REPORT

19261/20 Rigging up1/272/4 D lg 800'2/102/17 Sand 1525-156050 gts 30 oil 5 Water

K17 KANSAS

Map No. _____ Sec. 10 Twp. 23 R. 13

Well No. 20 Schneider Company

Theta Oil Co. _____ Contractor

COMPLETED

SECTION PLAT

200 _____ Ft. from N. Line

_____ Ft. from S. Line

_____ Ft. from E. Line

200 _____ Ft. from W. Line

0			

Location _____

Rig up _____

Drilling and Remarks:

501 30 ft. oil
5 ft. water

RECORD

Cased _____ in., _____ ft.

Sand 1525-1560

Gas _____

Oil _____

Total Depth 1560

PRODUCTION

1st 24 hrs. Nat. _____

1st 24 hrs. after shot _____

Gas _____ Cu. Ft.

Dry Hole _____

Abandoned _____

Date

FEB 17 1926

CHAS. L. SHERWOOD

Scout

S. Sherwood Co

K17 KANSAS Sec. 10 Twp. 23 R. 13

Well No. 20 Schneider
Heta Oil Co Company

Contractor

FIRST REPORTS

200 Ft. from N. Line

Ft. from S. Line

Ft. from E. Line

200 Ft. from W. Line

SECTION PLAT

0			

Location

Rig up

Drilling and Remarks:

Rigging up

RECORD

Cased _____ in., _____ ft.

Sand _____

Gas _____

Oil _____

Total Depth _____

PRODUCTION

1st 24 hrs. Nat. _____

1st 24 hrs. after shot _____

Gas _____ Cu. Ft.

Dry Hole _____

Abandoned _____

Date

JAN 20 1926

CHAS. L. SHERWOOD

192

Scout