


Map No. _____ Sec. 9 Twp. 23 R. 13
Well No. 3 Anthony Farm _____
Gore et al Company _____

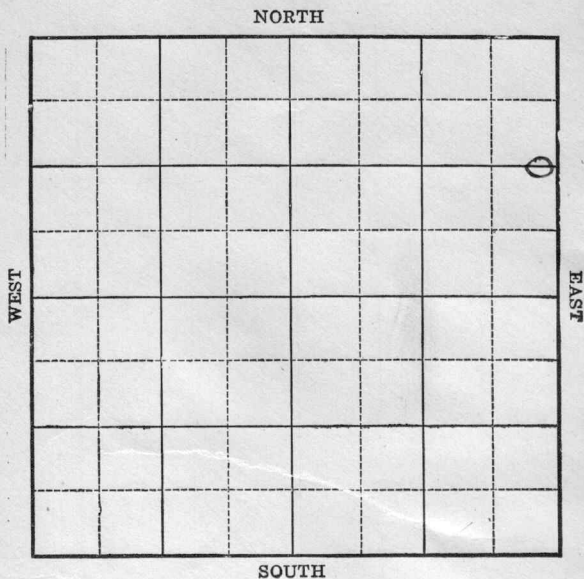

Location _____

Drilling Remarks:

Rig up _____

Drilling Remarks:

RECORD

Cased _____ in. _____ ft.

Sand _____

Gas _____

Oil _____

Total Depth _____

PRODUCTION

1st 24 hrs Nat. _____

1st 24 hrs. after shot _____

Gas _____ cu. ft.

Dry Hole _____

Abandoned _____

Map No. _____ Sec. 9 Twp. 23 R. 13Well No. 3 Inthurn Farm _____
Jone Etal Company _____


NORTH

1320 Ft. from N. Line

_____ Ft. from S. Line

200 Ft. from E. Line

_____ Ft. from W. Line

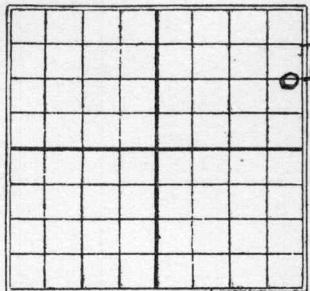

SOUTH

Date

REPORT

19233/2 Location.
6/10 Sand 15 85-1610
shot 80 gts. 15 lbs.

Map No. **KANSAS** 17 Sec. 9 Twp. 23 R. 13
Well No. 3 Inthurn
Sore etalo Company
Contractor

COMPLETED SECTION PLAT

1320 Ft. from N. Line
Ft. from S. Line
200 Ft. from E. Line
Ft. from W. Line

			⊙

Location _____
Rig up _____
Drilling and Remarks:

Sand 1575
1610
80/15

RECORD

Cased _____ in., _____ ft.
Sand _____
Gas _____
Oil _____
Total Depth _____

PRODUCTION

1st 24 hrs. Nat. _____
1st 24 hrs. after shot _____
Gas _____ Cu. Ft.
Dry Hole _____
Abandoned _____

Date JUN 10 1923
192 M. A. BENEAR Scout

Map No. **KANSAS** 17 9 Sec. Twp. 23 R. 13

Well No. 3 *2 m thurm*
Gore et al

Company

Contractor

FIRST REPORT

SECTION PLAT

1320 Ft. from N. Line

Ft. from S. Line

200 Ft. from E. Line

Ft. from W. Line

			0

Location *RV*

Rig up

Drilling and Remarks:

RECORD

Cased _____ in., _____ ft.

Sand _____

Gas _____

Oil _____

Total Depth _____

PRODUCTION

1st 24 hrs. Nat. _____

1st 24 hrs. after shot _____

Gas _____ Cu. Ft.

Dry Hole _____

Abandoned _____

Date

MAR 2 1923

M. A. BENEAR

191

Scout