


Section 29 Township 28 Range 1EWell No. 1 ChamberlinCompany Petroleum Inc.

NORTH

WEST

EAST

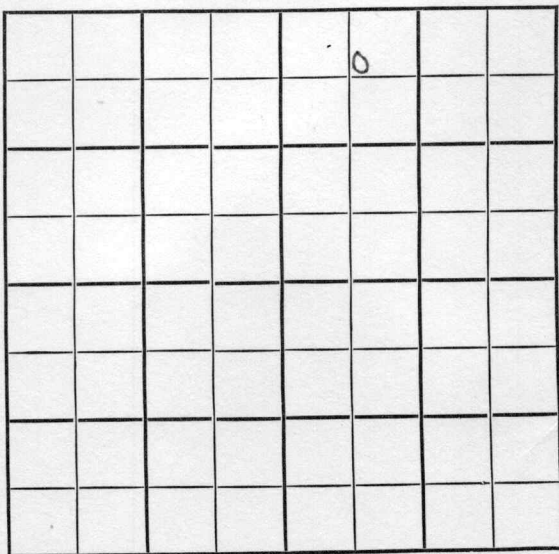

SOUTH

Sedgwick

KANSAS

SEC.	29	TWP.	28	R.	1E
------	----	------	----	----	----

WELL NO.

1 Chamberlin

FARM

COMPANY

Petroleum Inc.

CONTRACTOR

Garvey

Gladys

KANSAS

560

Ft. from N. Line


Ft. from S. Line

1880

Ft. from E. Line

Ft. from W. Line

SW NE NW NE

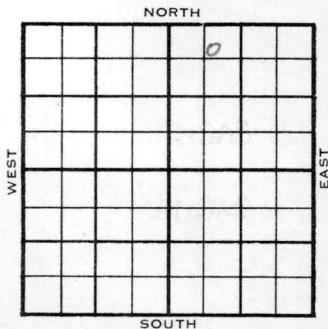

1955

ELEVATION

1273

REPORT

7/27

Comm 7-23-55

8" @ 141/160

Drlg 650

8/3

DSt 3110-43 open 1½ hr. Rec 20' vso &
gcm 435# TD 3143 D&A

KC

2616

1343

M. Dolo.

3109

1836

TD. 3143

ABANDONED

County Sedgwick Elev. _____
 Sec. 29 Twp. 28 Rge. 1E
 Company Petroleum Inc.
 Farm Name Chamberlin No. 1

TOPS	DEPTH	LOG	DATUM	Loc. in Sec.
Anh.				SW NE NW NE
Tp.				560' NL
H.				1880' EL
Tr.				Geol.
Dg.				Contr.
BL.				Garvey
L.				Pool
K.C.				Gladys
B.K.C.				FIRST REPORT JUL 27 '55
Ce.				
C.				
M.				
M.				
K.				
Mz.				
Mq.				
V.				
S.				
S.				No.
A				
R.				
PE.				
G.				
TD.				

Date Comm. 7-23-55

8" @ 141/160 drlg. 650

County Sedgwick Elev. 1273 Co.
 Sec. 29 Twp. 28 Rge. 1E
 Company Petroleum Inc.
 FarmName Chamberlin No. 1

TOPS	DEPTH	LOG	DATUM
Anh.			
TP.			
H.			
Tr.			
Dg.			
BL.			
L.			
K.C.	<u>2616</u>		<u>1343</u>
B.K.C.			
Ce.			
C.			
M. <u>Dals</u>	<u>3109</u>		<u>1836</u>
M.			
K.			
Mz.			
Mq.			
V.			
S.			
S.			
A.			
R.			
PE.			
G.			
TD.	<u>3143</u>		

Loc. in Sec. SW NE NW NE

560' NL

1880' EL

Geol. _____

Contr. _____

Garvey

Pool _____

Gladys



ABANDONED

Date Comm. 7-23-55 AUG 3 1955
8" @ 141/160 DST 3110-43 open 1½ hr.
Rec. 20' vso & gcm 4 35# TD 3143
D & A