


DX 78-1

Sedgwick

Section 29 Township 28 Range 1E **KANSAS**
Well No. #1 J. Crowl
Company Laura Jane Oil

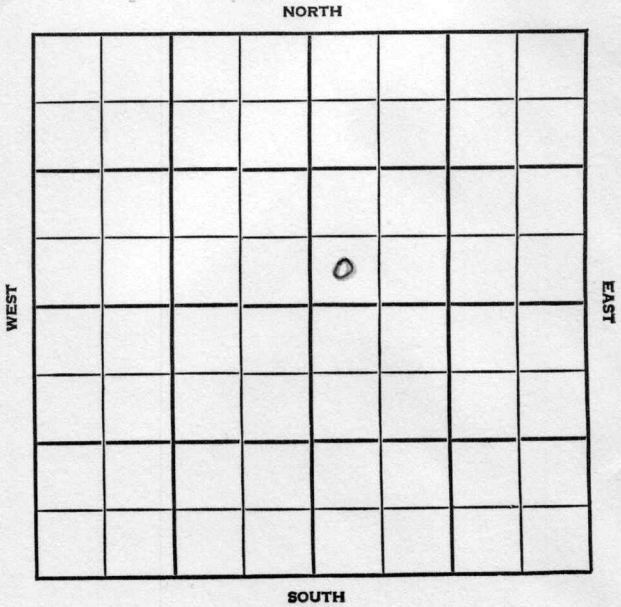

Sedgwick

KANSAS

SEC. 29	TWP. 28	R. 1E
------------	------------	----------

WELL NO.

1 J. Crowl

FARM

COMPANY

Laura Jane Oil

CONTRACTOR

Co. Tools

Gladys Pool

Ft. from N. Line

165'


Ft. from S. Line

Ft. from E. Line

165'

Ft. from W. Line

SW SW NE

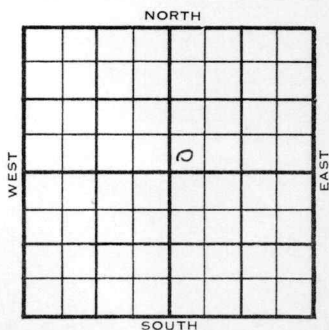

1955

ELEVATION

1270'

REPORT

5/25

Spud 5-19-55

8" @ 162 Drlg 2100

6/22

Comm 5-19-55

Stell Sd 2282, KC 2618, Dolo 3137

8" @ 162/160 5 1/2" @ 3137/100

DD 1 boph CO to 3171 Comp

135 bopd

COMPLETED

County Sedgwick State Kansas
 Sec. 29 (Blk. 28 (Sur. 1E Map No.
 (Twp.) (Rge.)
 Operator Laura Jane Oil
 Well No. 1 Farm J. Crowl
 Elev. 1270 Location SW SWNE



165 Ft. From S Line NE
165 Ft. From W Line Quarter
1st. Report MAY 2 5 1955
Completion
Remarks
Co. tools
Spudding Date 5-19-55

Drlg. Data

Gladys Pool8" @ 162 drlg. 2100

[illegible]

Date Comm.	5-19-55	JUN 22 1955	Sec
8" @ 162/160	5 $\frac{1}{2}$ " @ 3137/100	DD 1 bopd	
CO to 3171	Comp. 135 bopd		