

Sedgwick


KANSAS

Section 29 Township 28 Range 1E

Well No. 1 Clem

Company Perroleum Inc.

NORTH

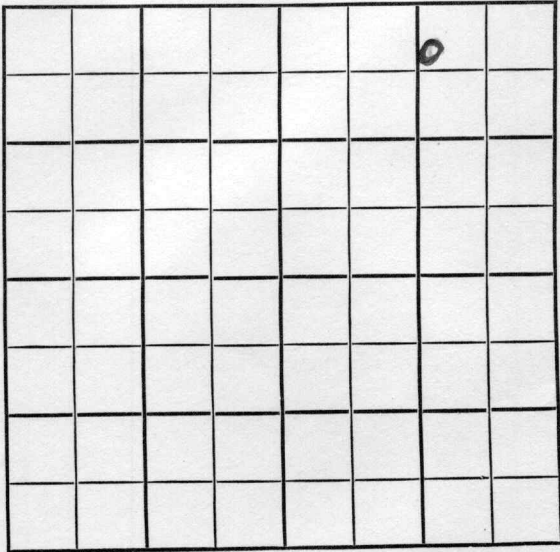

WEST

EAST

SOUTH

SEC.	TWP.	R.
29	28	1E

WELL NO. 1 Clem FARM

COMPANY Petroleum Inc.

CONTRACTOR Co. Tools Gladys


603 Ft. from N. Line

Ft. from S. Line

1220 Ft. from E. Line

Ft. from W. Line

SW NW NE NE

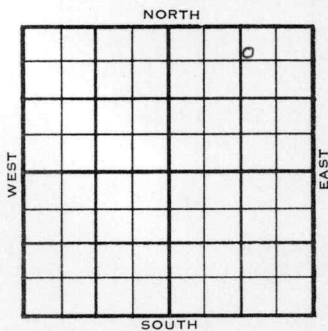

1955	ELEVATION	REPORT
------	-----------	--------

6/29 Comm 6-25-55  
8" @ 137  
Drlg 1580

7/7 DST 3132-37 open 1 hr. Rec. 34' mud  
0/20" DST 3133-41 open 1hr gas in 17  
min Rec. 50' ocm 550/15" DST 3141-51  
open 1 hr. Rec. 6' mud 0/20" DST 3150  
-92 open 1 hr. Rec 75' mud 425/20" D&A

Tops:	Depth	Datum
Mch.	3124	1849
M. Dolo.	3122	1847
TD	3220	

**ABANDONED**



