
DX 78-1

KANSAS

Section 29 Township 28 Range 1E

Well No. #1 Gibson

Company Adair

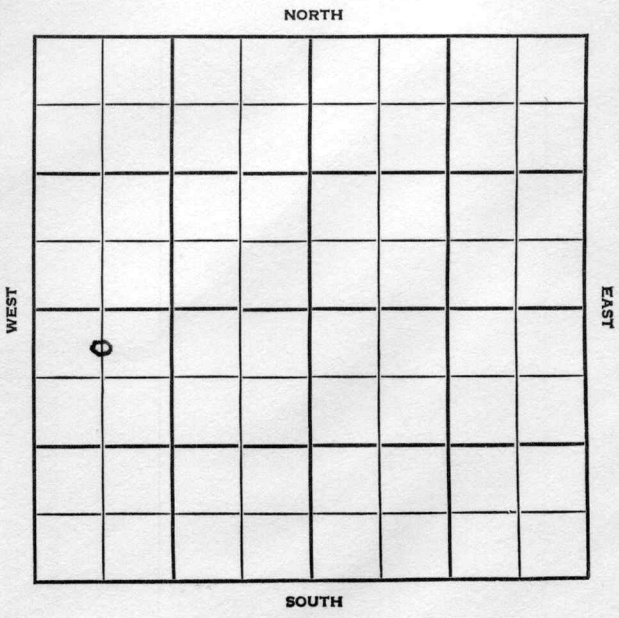

Sedgwick KANSAS

SEC.	TWP.	R.
29	28	1E

WELL NO.

1 Gibson FARM

COMPANY

Adair

CONTRACTOR

Co. Tools


Gladys Pool

330 Ft. from N. Line

_____ Ft. from S. Line

_____ Ft. from E. Line

660 Ft. from W. Line

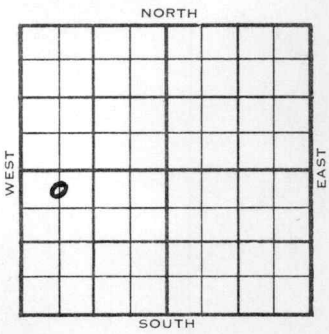

C N/2 NW SW

ELEVATION 1955	REPORT
4/13	Spud 4-11-55 8" @150', WOC

DX-78

FORM 275 FOR SALE BY KANSAS BLUE PRINT CO.


County Sedgwick State Kansas

Sec. 29 (Blk. Twp.) 28 (Sur. Rge.) 1E Map No.

Operator Adair

Well No. 1 Farm Gibson

Elev. Location C N½ NW SW

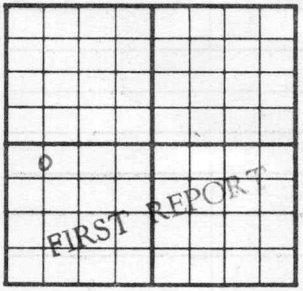

330 Ft. From N Line SW

660 Ft. From W Line Quarter

1st. Report APR 13 1955

Completion

Remarks

Co. tools

Spudding Date 4-11-55

Drlg. Data Gladys Pool

8" @ 150 WOC

FABEN GILSTRAP