
DX 78-1

KANSAS

Section 29 Township 28 Range 1E

Well No. #1 Haws

Company ~~Stelbar Oil~~ FRANCIS RAYMOND

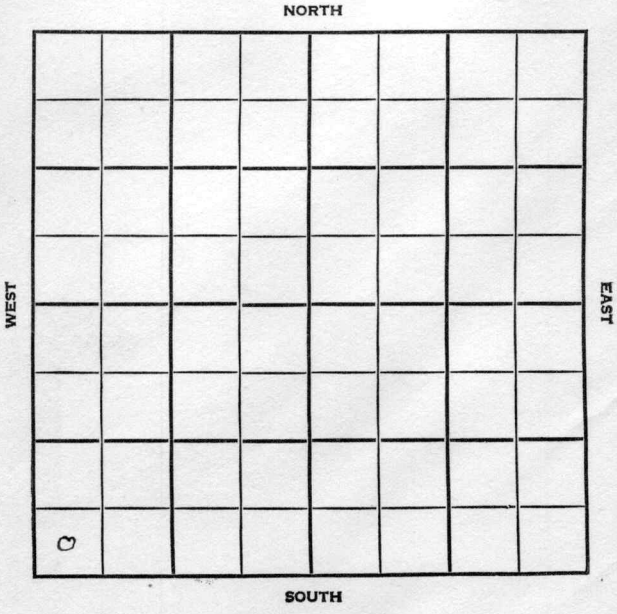

Sedgwick KANSAS

SEC.	TWP.	R.
29	28	1E

WELL NO. 1 Haws FARM

COMPANY ~~Telbar Oil~~ Francis Raymond

CONTRACTOR

Gladys Pool


_____ Ft. from N. Line

250 Ft. from S. Line

_____ Ft. from E. Line

200 Ft. from W. Line

SW SW SW

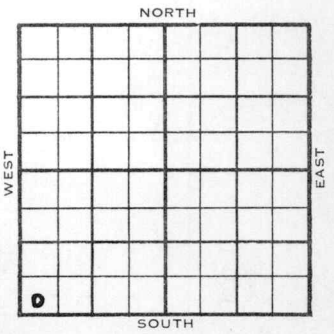

1955	ELEVATION 1266'	REPORT
4/13	C&P	
6/22	Comm 4-22-55 KC 2636 Ch 3135, Lm 3140, Dolo 3154 TD 3188 8 5/8" @ 145/120 5 1/2" @ 3188/60 DD 3193 FU 1000' oil HFO in 12 hr 24/3175-83 30/3157-67 F/90 boph 4 hr Comp F 977 bopd COMPLETED	

DX-78

FORM 275 FOR SALE BY KANSAS BLUE PRINT CO.


County Sedgwick State Kansas

Sec. 29 (Blk. / Twp.) 28 (Sur. / Rge.) 1E Map No.

Operator Stelbar Oil

Well No. 1 Farm Haws

Elev. 1266 Location SW SW SW

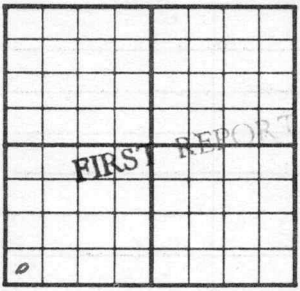

250 Ft. From S Line SW

200 Ft. From W Line Quarter

APR 13 1955

1st. Report

Completion

Remarks

Spudding Date

Drlg. Data Gladys Pool

Cellar & pits

FABEN GILSTRAP

correct

FORM 513 REV. SUNRAY

County Sedgwick Elev. 1266 Co.

Sec. 29 Twp. 28 Rge. 1E

Company Francis Raymond (was Stelbar Oil)

Farm Name Haws No. 1

TOPS	DEPTH	LOG	DATUM
Anh.			
Tp.			
H.			
Tr.			
Dg.			
B.L.			
L.			
K.C.	2636		1370
B.K.C.			
Ce.			
C. ch	3135		1869
M. Lm	3140		1874
M. Dolo	3154		1888
K.			
Mz.			
Mo.			
V.			
S.			
S.			
A			
R.			
P€.			
G.			
T.D.	3188		

Loc. in Sec. SW SW SW

250' SL

200' WL

Geol.

Contr.

Lse.

Pool

COMPLETE

0

No.

Date Comm. 4-22-55 JUN 2 2 1955 Sec.

8 5/8" @ 145/120 5½" @ 3188/60 T.

DD 3193 FU 1000' oil HFO in 12 hr.

24/ 3175-83 30/ 3157-67 F/ 90 boph

4 hr. Comp. F. 977 bopd R.