


Map No. _____ Sec. 4 Twp. 27 R. 4
 Well No. 1 Hammond Farm
Cosden Oil Company

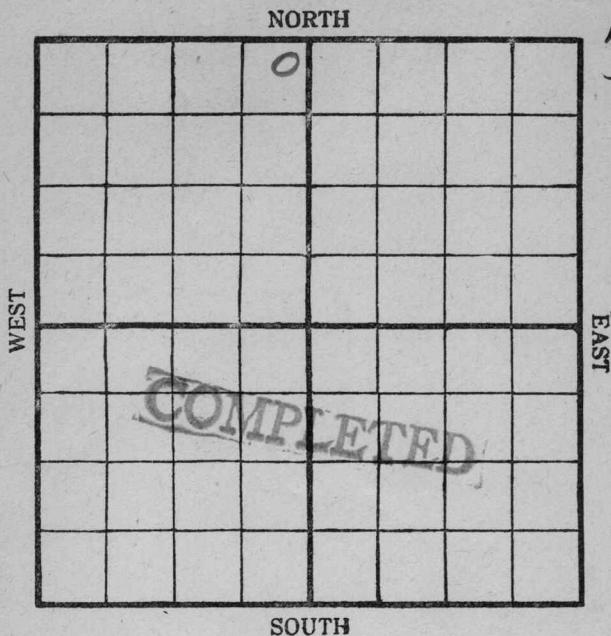

Location _____

Drilling Remarks:

Rig Up _____

Drilling Remarks:

RECORD

Cased _____ in. _____ ft.

Sand _____

Gas _____

Oil _____

Total Depth _____

PRODUCTION

1st 24 hrs. Nat. _____

1st 24 h.s. after shot _____


Gas _____ cu. ft

Dry Hole _____

Abandoned _____

1001
Map No. K11 Sec. 4 Twp. 27S. R. 4EWell No. 1 H. Hammond FarmCosden Oil & Gas Company

NORTH

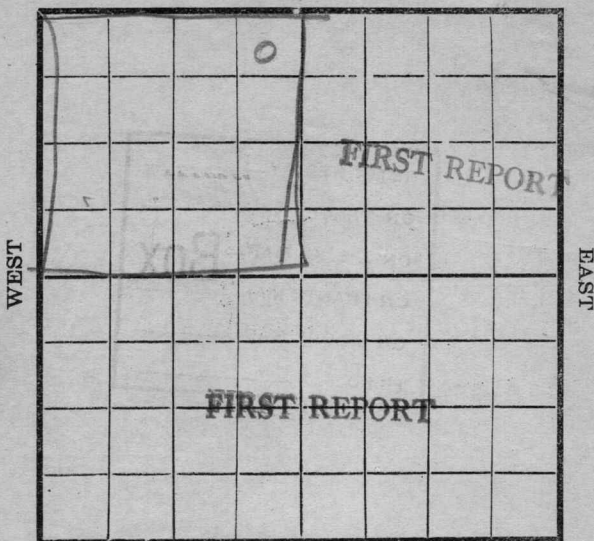

SOUTH

Location ✓Rig Up manDrilling and remarks man

200' from
North line
200' from
East line.

RECORD

Cased _____ in. _____ Ft.

Sand _____

Gas _____

Oil _____

Total Depth _____

PRODUCTION

1st 24 hrs. Nat. _____

1st 24 hrs. after shot _____

Gas _____ Cu. Ft.

Dry Hole _____

Abandoned _____

Date


_____, 191____ Capt. Dept Scout

Map No. 11 Sec. 4 Twp. 27 R. 4

Well No. 1 Farm 1
Cosden Company

NORTH

WEST

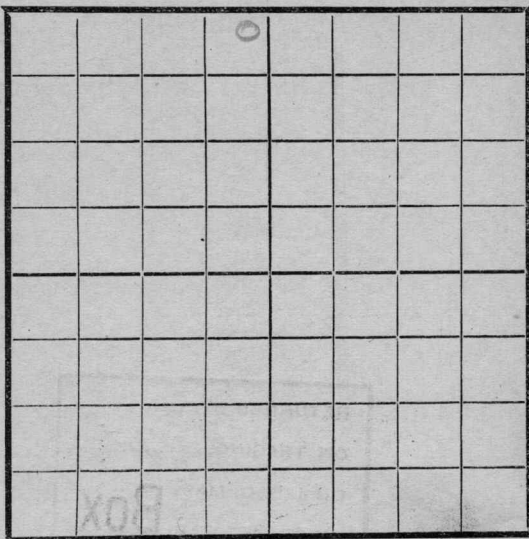

EAST

SOUTH

RECORD

Location ✓
 Rig Up ✓
 Drilling and remarks

Cased in Ft.
 Sand
 Gas
 Oil
 Total Depth

PRODUCTION

1st 24 hrs. Nat.
 1st 24 hrs. after shot
 Gas Cu. Ft.
 Dry Hole
 Abandoned

FIRST REPORT


Date

4/9, 1911 A. C. Cady Scout

Map No. _____ Sec. 4 Twp. 27 R. 4Well No. Hammond Farm _____
Casden Company

NORTH

WEST

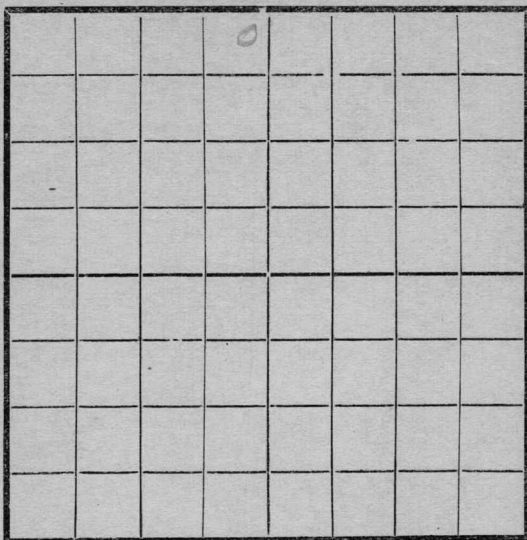

EAST

SOUTH

Location _____

Rig Up _____

Drilling and remarks

St. Raining
225

RECORD

Cased _____ in. _____ Ft.

Sand _____

Gas _____

Oil _____

Total Depth _____

PRODUCTION

1st 24 hrs. Nat. _____

1st 24 hrs. after shot _____

Gas _____ Cu. Ft.

Dry Hole _____


Abandoned _____

Date

5/1, 191 *8* *Casden* Scout

Map No. _____ Sec. 4 Twp. 27 R. 4
Well No. 1 Hammer Farm
Candler Company

NORTH

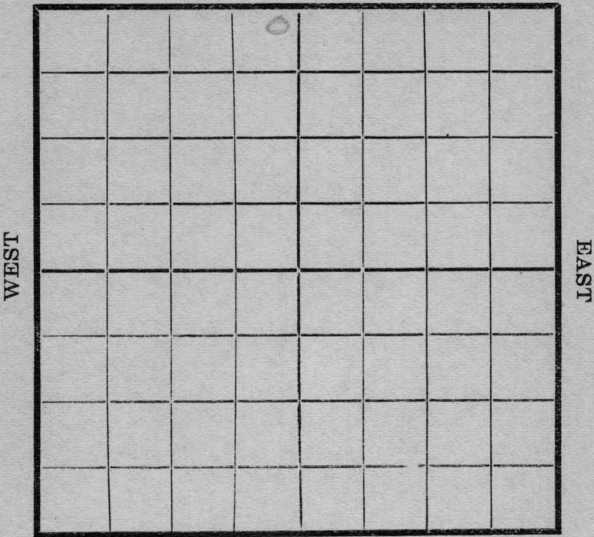

SOUTH

Location _____
Rig Up _____
Drilling and remarks

*LD at
400
Boiler
Trouble*

RECORD

Cased _____ in. _____ Ft.
Sand _____
Gas _____
Oil _____
Total Depth _____

PRODUCTION


1st 24 hrs. Nat. _____
1st 24 hrs. after shot _____
Gas _____ Cu. Ft.
Dry Hole _____
Abandoned _____

Date 5/8, 1918 S. Candler Scout

Map No. _____ Sec. 4 Twp 27 R. 4Well No. 1 Hammer Farm _____
Crocker Company

NORTH

WEST

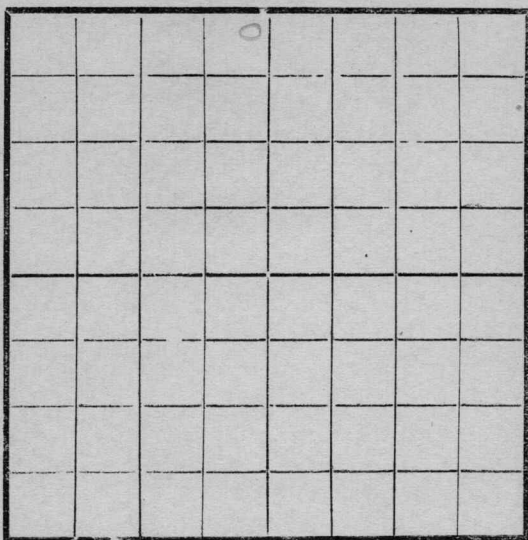

EAST

SOUTH

RECORD

Location _____

Rig Up _____

Drilling and remarks

Cased _____ in. _____ Ft.

Sand _____

Gas _____

Oil _____

Total Depth _____

PRODUCTION

1st 24 hrs. Nat. _____

1st 24 hrs. after shot _____

Gas _____ Cu. Ft.

Dry Hole _____

Abandoned _____

Date

4/15, 1918 C. Crocker Scout


1001 R11 Map No. Sec. 4 Twp. 27 R. 4

Well No. 1 Farm

Company

NORTH

WEST

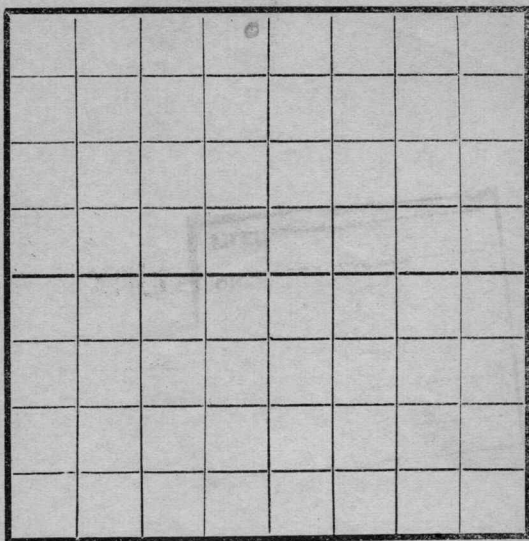

EAST

SOUTH

Location -----

Rig Up -----

Drilling and remarks

225

RECORD

Cased ----- in. ----- Ft.

Sand -----

Gas -----

Oil -----

Total Depth -----

PRODUCTION

1st 24 hrs. Nat. -----

1st 24 hrs. after shot -----

Gas ----- Cu. Ft.

Dry Hole -----

Abandoned -----


Date

4/24, 1918 Scout

Map No. _____ Sec. 4 Twp. 27 R. 4Well No. 1 Hammond FarmCusden Company

NORTH

WEST

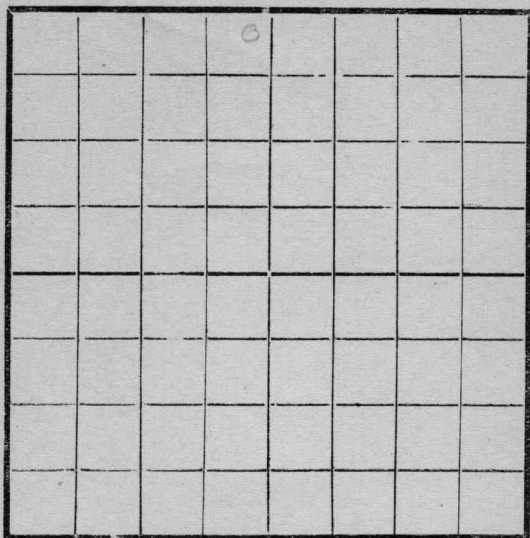

EAST

SOUTH

Location _____

Rig Up _____

Drilling and remarks

1270

RECORD

Cased _____ in. _____ Ft.

Sand _____

Gas _____

Oil _____

Total Depth _____

PRODUCTION

1st 24 hrs. Nat. _____

1st 24 hrs. after shot _____

Gas _____ Cu. Ft.


Dry Hole _____

Abandoned _____

Date

5/25, 1918 Cusden Scout

NORTH

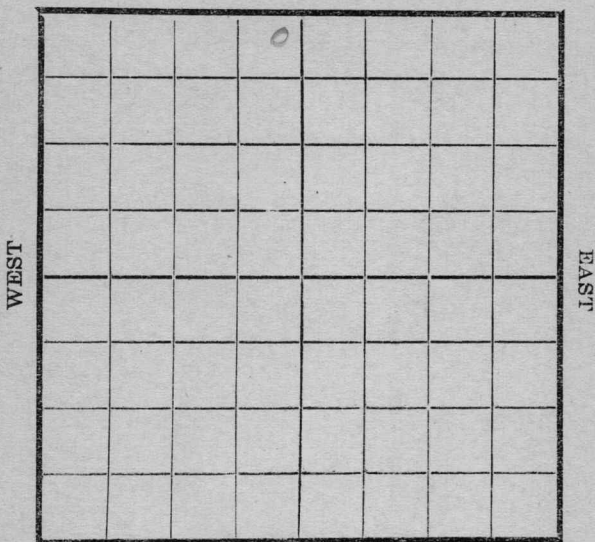

SOUTH

Location _____

Rig Up

Drilling and remarks

85
1450

RECORD

Cased_____ in_____Ft

Sand

Gas

Oil _____

Total Depth -----

PRODUCTION

1st 24 hrs. Nat.-----

1st 24 hrs. after shot-----

Gas ----- Cu. Ft

Dry Hole -----


Abandoned _____

Date 5/20 1918 C. C. C. Scout

Map No. _____ Sec. 4 Twp. 27 R. 4Well No. 1 Hammer FarmCasden Company

NORTH

WEST

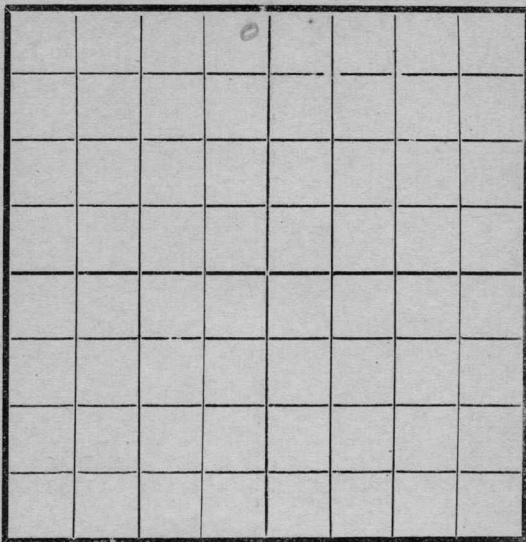

EAST

SOUTH

Location _____

Rig Up _____

Drilling and remarks

RECORD

Cased _____ in. _____ Ft.

Sand _____

Gas _____

Oil _____

Total Depth _____

PRODUCTION

1st 24 hrs. Nat. _____

1st 24 hrs. after shot _____

Gas _____ Cu. Ft.

Dry Hole _____

Abandoned _____

Date

6/5, 1918 Casden Scout


6/14 191 J. C. ... Scout

Map No. _____ Sec. 4 Twp. 27 R. 4Well No. 1 Hammer

_____ Company

_____ Contractor

NORTH

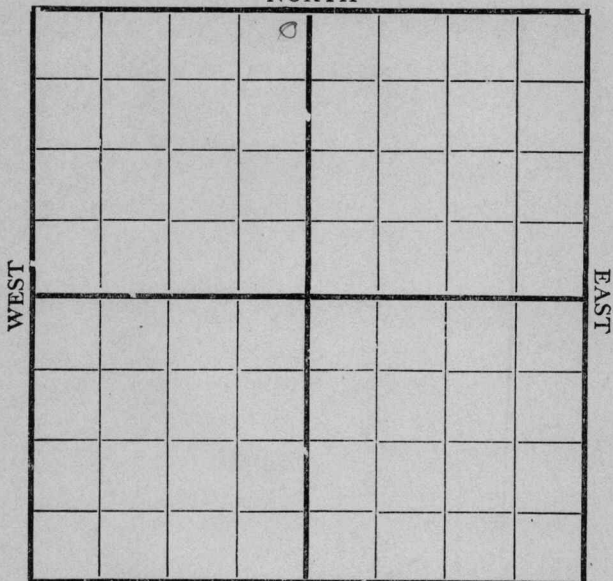

SOUTH

Location _____

Rig up _____

Drilling and Remarks:

2220

RECORD

Cased _____ in., _____ ft.

Sand _____

Gas _____

Oil _____

Total Depth _____

PRODUCTION

1st 24 hrs. Nat. _____

1st 24 hrs. after shot _____

Gas _____ Cu. Ft.

Dry Hole _____

Abandoned _____


Date

6/19 1918 Conley Scout

Map No. _____ Sec. 4 Twp. 27 R. 4Well No. 1 Hammond

_____ Company

_____ Contractor

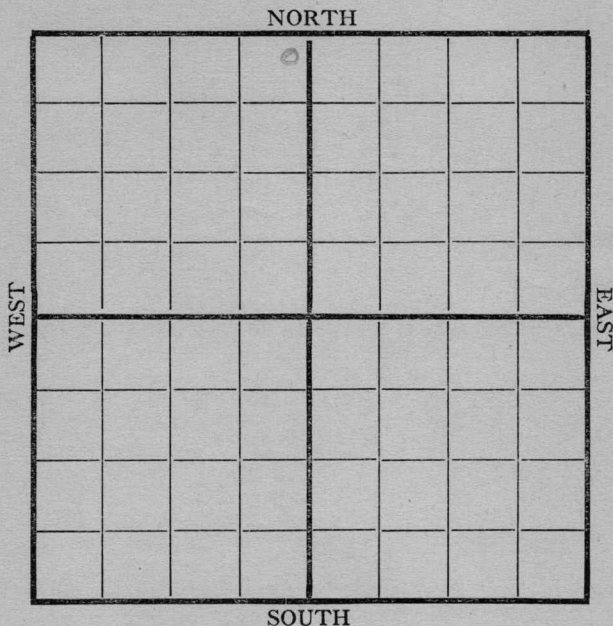

Location _____

Rig up _____

Drilling and Remarks:

Drilled to 23308" casing collapsedat 2280**RECORD**

Cased _____ in., _____ ft.

Sand _____

Gas _____

Oil _____

Total Depth _____

PRODUCTION

1st 24 hrs. Nat. _____

1st 24 hrs. after shot _____

Gas _____ Cu. Ft.

Dry Hole _____

Abandoned _____


Date

6/26 1918 Condit Scout

Map No. _____ Sec. 4 Twp. 27 R. 4Well No. 176
Condon Company

Contractor _____

NORTH

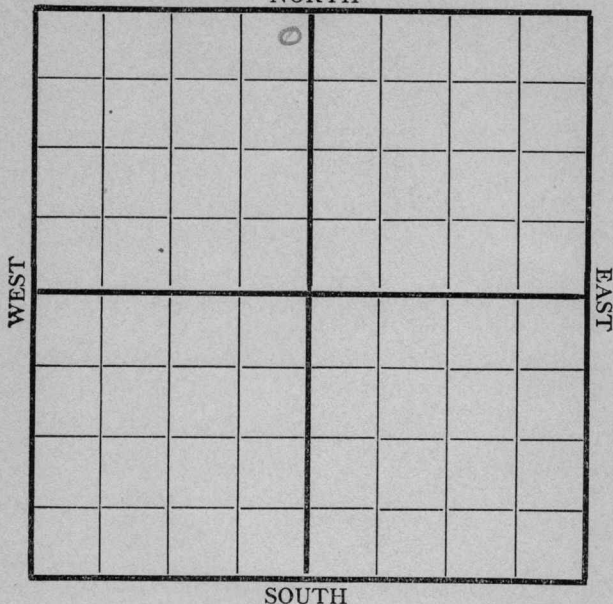

SOUTH

Location _____

Rig up _____

Drilling and Remarks:

2350

RECORD

Cased _____ in., _____ ft.

Sand _____

Gas _____

Oil _____

Total Depth _____

PRODUCTION

1st 24 hrs. Nat. _____

1st 24 hrs. after shot _____

Gas _____ Cu. Ft.

Dry Hole _____

Abandoned _____

Date

7/3

191

J. Condon

Scout

Map No. _____ Sec. 4 Twp. 27 R. 4
Well No. 1 _____
Casden _____ Company
_____ Contractor

NORTH

WEST

EAST

SOUTH

Location

Rig up

Drilling and Remarks:

2560

RECORD

Cased _____ in., _____ ft.

Sand _____

Gas

Oil

Total Depth.....

PRODUCTION

1st 24 hrs. Nat.

1st 24 hrs. after shot-----

Gas.....Cu. Ft.


Dry Hole

Abandoned.....

Date _____

7/10 1918 E. C. Cady Scout

Map No. _____ Sec. 4 Twp. 37 R. 4
Well No. 1 Hammer
_____ Company
_____ Contractor

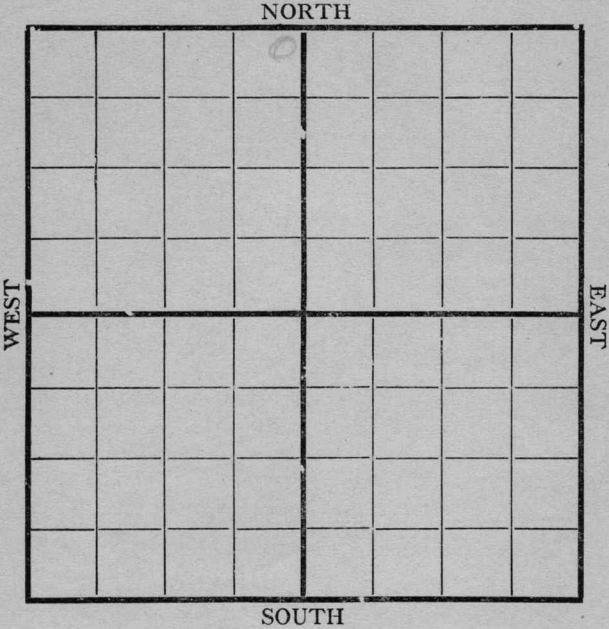

Location _____ Rig up _____ Drilling and Remarks: <u>Top sand</u> <u>2595</u> <u>Have bit in</u> <u>hole 2660</u> <u>Still in dry</u> <u>oil sand</u>	RECORD
	Cased _____ in., _____ ft.
	Sand _____
	Gas _____
	Oil _____
	Total Depth _____
	PRODUCTION
	1st 24 hrs. Nat. _____
	1st 24 hrs. after shot _____
	Gas _____ Cu. Ft.
	Dry Hole _____
	Abandoned _____


Date 7/17 1918 P. C. C. C. Scout

Map No. K11 Sec. 4 Twp. 27 R. 4

Well No. 1 Hamm

Casden Dickson Company

Contractor

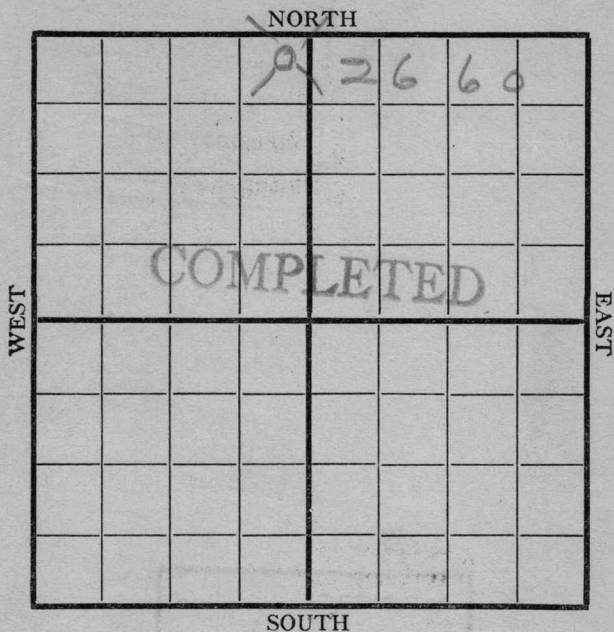

Location _____

Rig up _____

Drilling and Remarks:

Dry and
abandoned
2660

RECORD

Cased _____ in., _____ ft.

Sand 2595-2660 dry

Gas _____

Oil _____

Total Depth _____

PRODUCTION

1st 24 hrs. Nat. _____

1st 24 hrs. after shot _____

Gas _____ Cu. Ft.

Dry Hole _____

Abandoned _____

Date

7/23 1918 Casden Scout

Butler
K11 KANSAS

MAP No. _____ SEC. *✓* TWP. *27S* R. *✓E*

WELL No. *1* *Hammond*

Cosden Oil & Gas COMPANY

CONTRACTOR

SECTION PLAT

ABANDONED

_____ FT. FROM N. LINE

_____ FT. FROM S. LINE

_____ FT. FROM E. LINE

_____ FT. FROM W. LINE

LOCATION _____

RIG UP _____

DRILLING AND REMARKS:

RECORD

CASED _____ IN. _____ FT.

SAND _____

GAS _____

OIL _____

TOTAL DEPTH *2660*

PRODUCTION

1ST 24 HRS. NAT. _____

1ST 24 HRS. AFTER SHOT _____

GAS _____ CU. FT.


DRY HOLE *✓*

ABANDONED

DATE

7/23/18 192 _____ SCOUT

Map No. K11 Sec. 4 Twp. 27S R. 4E
 Well No. 1 H. Hammond
Gosden Oil and Gas Company
 Contractor

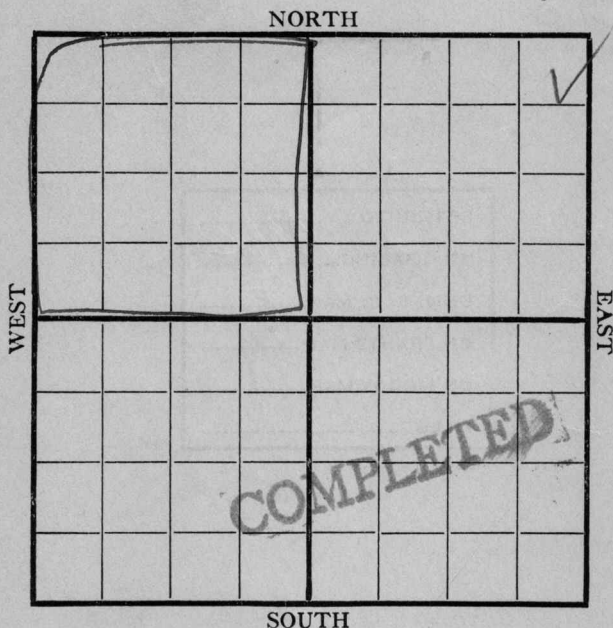

Location _____

Rig up _____

Drilling and Remarks:

Completed
July 20.

RECORD

Cased _____ in., _____ ft.

Sand _____

Gas _____

Oil _____

Total Depth 2666'

PRODUCTION

1st 24 hrs. Nat. _____

1st 24 hrs. after shot _____

Gas _____ Cu. Ft.

Dry Hole ☒ _____

Abandoned _____

Date

Aug 21 1918 Eng Dept Scout
MI