Gofbey

Form 51—5M—2-29—34703

Map No. KANSAS Sec. 11 Twp. 23 R. 13

Well No. 4 - Maztkus Farm

Libo O & G Company

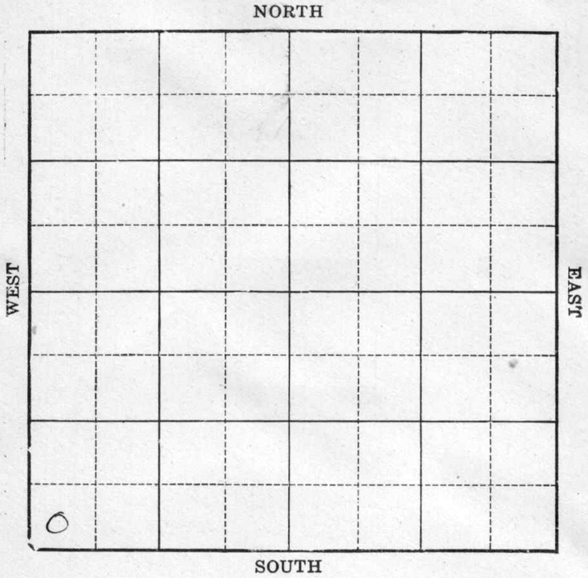

Location	Rig Up
Drilling Remarks	Drilling Remarks

RECORD	PRODUCTION
Cased ______ in. ______ ft.	1st 24 hrs. Nat.
Sand	1st 24 hrs. after shot
Gas	Gas ______ cu. ft.
Oil	Dry Hole
Total Depth	Abandoned

Form 26—1M Bks.—9-26

Copper

Map No. Kns Sec. 11 Twp. 23 R. 13

Well No. 4 Moztkus

Lebo O & G Co Company

Contractor

FIRST REPORTS

COMPLETED

Ft. from N. Line

Ft. from S. Line

Ft. from E. Line

Ft. from W. Line

SECTION PLAT

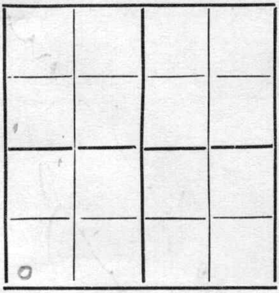

Location

Rig up

Drilling and Remarks:

80/ Very Small Well

RECORD

Cased in., ft.

Sand 1811 - 1830

Gas

Oil

Total Depth 1830

PRODUCTION

1st 24 hrs. Nat.

1st 24 hrs. after shot

Gas Cu. Ft.

Dry Hole

Abandoned

Date

11/16/21 192

Sherwood Scout