


Map No. Kansas Sec. 10 Twp. 23 R. 13
 Well No. 22 Schnieder & Young Farm
Theta Oil Company

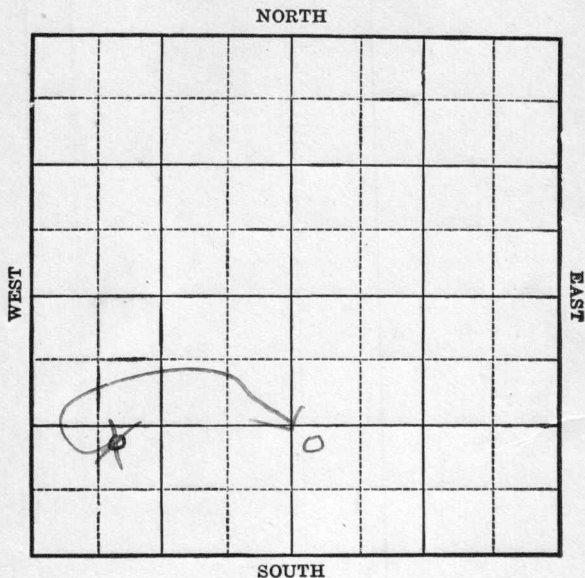

Location _____

Drilling Remarks:

Rig Up _____

Drilling Remarks:

RECORD

Cased _____ in. _____ ft.

Sand _____

Gas _____

Oil _____

Total Depth _____

PRODUCTION

1st 24 hrs. Nat. _____

1st 24 hrs. after shot _____

Gas _____ cu. ft.

Dry Hole _____

Abandoned _____


Map No. Kansas Sec. 10 Twp. 23 R 13
 Well No. 8 young ~~Schneider~~ Farm
Theta Company

_____ Ft. from N. Line

1120 Ft. from S. Line

_____ Ft. from E. Line

760 Ft. from W. Line

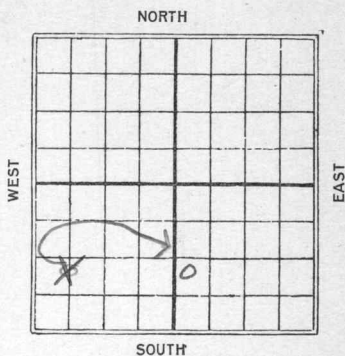

C.

Date

REPORT

1925

3/24 Rig up

4/10

5/29 \$ 1800 Sly


6/5 \$1788 01790-1878 T.D. 35/5 lbs oil
25" water

Map No. *27 Kansas* Sec. *10* Twp. *23* R. *13 E*Well No. *8 Young**Photo oil co* Company

Contractor

CORRECTION

SECTION PLAT

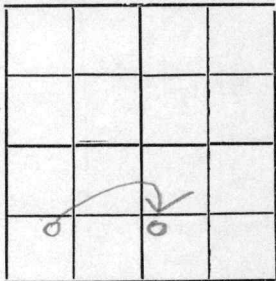

Ft. from N. Line

1120 Ft. from S. Line

Ft. from E. Line

250 Ft. from W. Line

Location

Rig up

Drilling and Remarks:

*Spudding**chg location**" well no**" farm name*

CORRECTION

RECORD

Cased _____ in., _____ ft.

Sand _____

Gas _____

Oil _____

Total Depth _____

PRODUCTION

1st 24 hrs. Nat. _____

1st 24 hrs. after shot _____

Gas _____ Cu. Ft.

Dry Hole _____

Abandoned _____

Date

Was #22 Schneider
APR 10 1925

192

Chas L Sherwood Scout

Map No. Kndk Sec. 10 Twp. 23 R. 13Well No. 8 Young
Sheta Oil Co

Company

Contractor

SECTION PLAT

Ft. from N. Line

1120 Ft. from S. Line

Ft. from E. Line

250 Ft. from W. Line

COMPLETED

RECORD

Location

Cased in., ft.

Rig up

Sand Top 1788

Drilling and Remarks:

Gas

Oil 1790-1878Total Depth 1878

PRODUCTION

1st 24 hrs. Nat.

1st 24 hrs. after shot

Gas Cu. Ft.

Dry Hole

Abandoned

Date

JUN 5 1925

CHAS. L. SHERWOOD

Scout

35 / 5 b/s oil
125 " water.

Map No. **KANSAS** Sec. 10 Twp. 23 R. 13

Well No. 22 Schmid

Theta Company

Contractor

FIRST REPORT

_____ Ft. from N. Line

1120 Ft. from S. Line

_____ Ft. from E. Line

760 Ft. from W. Line

SECTION PLAT

0			

Location _____

Rig up ✓✓

Drilling and Remarks:

RECORD

Cased _____ in., _____ ft.

Sand _____

Gas _____

Oil _____

Total Depth _____

PRODUCTION

1st 24 hrs. Nat. _____

1st 24 hrs. after shot _____

Gas _____ Cu. Ft.

Dry Hole _____

Abandoned _____

Date

3/24 1925

M. A. BENEAR

Scout