


Section 10 Township 23 Range 13E

Well No. #4 Lizzie Young

Company Joe Phillips et al

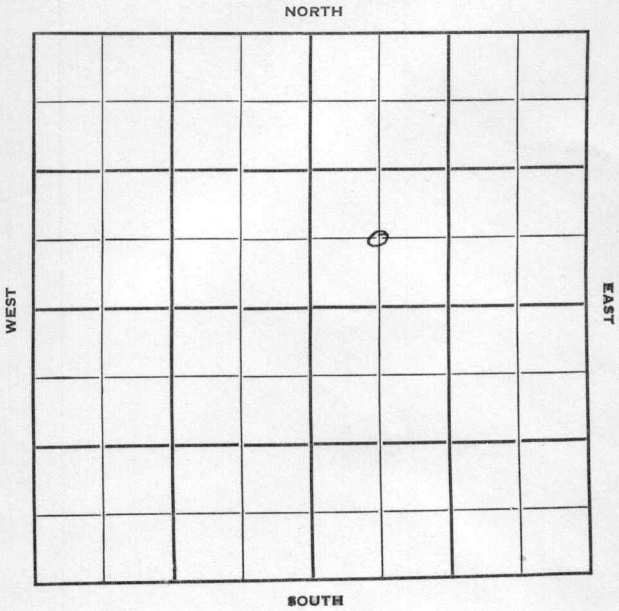

Sec. 10 Twp. 23 R. 13E

Well No. #4 Lizzie Young Farm

Joe Phillips et al Company

White & Ellis Contractor
Virgil Pool

Ft. from N. Line

660


Ft. from S. Line

Ft. from E. Line

660

Ft. from W. Line

C SW NE

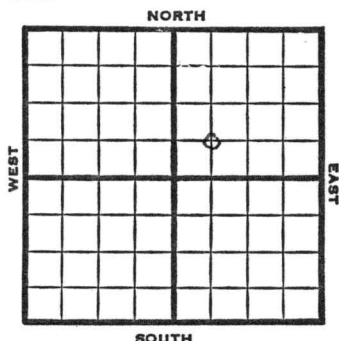

1952

REPORT

10/8

Location

10/29

Spud 10-10-52

Oil Well TD 1816'


8" @ 85'

Miss. 1783

TD 1802' 4" @ 1800'

DD 1816' 2000 A Comp. 25 bopd

COMPLETED

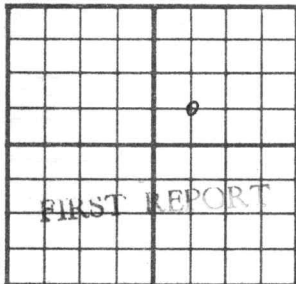County Greenwood State KansasSec. 10 (Blk.) 23 (Sur.) 13E Map No.
(Twp.) (Rge.)Operator Joe Phillips et al.Well No. 4 Farm Lizzie YoungElev. _____ Location C SW NE660 Ft. From S Line NE660 Ft. From W Line Quarter1st. Report OCT 8 1952

Completion _____


Remarks _____

White & Ellis - Contr.

Spudding Date _____

Drlg. Data Virgil PoolLocation

J. G. McGEHEE

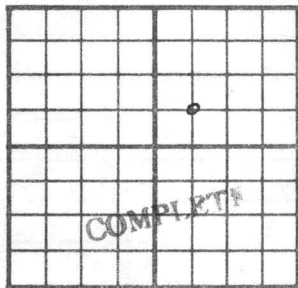County Greenwood State KansasSec. 10 (Blk.
Twp.) 23 (Sur.
Rge.) 13E Map No.Operator Joe Phillips et al.Well No. 4 Farm Lizzie YoungElev. Location C SW NE660 Ft. From S Line NE660 Ft. From W Line Quarter

1st. Report

Completion OCT 29 1952Remarks Virgil PoolWhite & Ellis - Contr.Spudding Date 10-10-52Drlg. Data Oil well TD 18168" @ 85 Miss. 1783 TD 1802 4" @ 1800DD 1816 2000 A Comp. 25 bopd

J. G. McGEHEE