
Form 51-10M-7-20-CroMac Kansas

Map No. K Sec. 10 Twp. 23 R. 13

Well No. 3 Shondee Farm

Phelps Oil Company

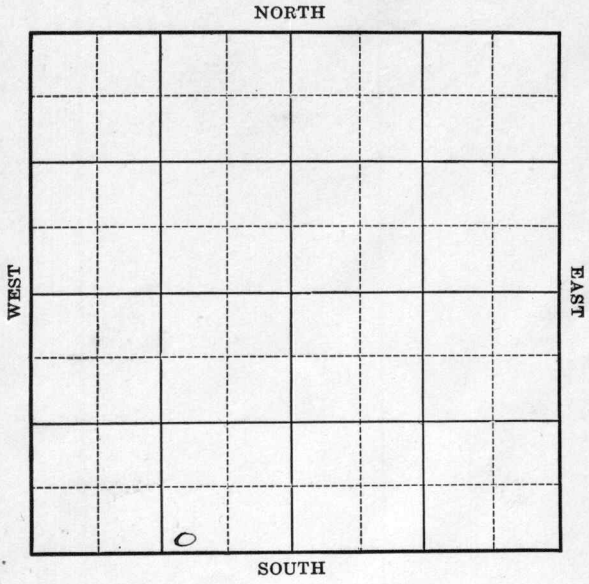

Location _____

Drilling Remarks:

Rig Up _____

Drilling Remarks:

RECORD

Cased _____ in. _____ ft.

Sand _____

Gas _____

Oil _____

Total Depth _____

PRODUCTION

1st 24 hrs. Nat. _____

1st 24 hrs. after shot _____

Gas _____ cu. ft.

Dry Hole _____

Abandoned _____

Form 252A 8M-11-20 PALACE-TULSA 4617

Map No. _____ Sec. 10 Twp. 23 R. 13

Well No. 3 Schneider Farm


Theta Oil Company

_____ Ft. from N. Line

200 Ft. from S. Line

1120 Ft. from E. Line

_____ Ft. from W. Line

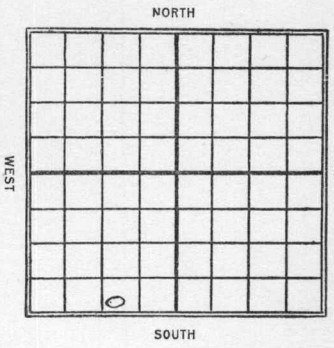

Date 1922	REPORT
2/15	Dly 700
3/12	Sand 1627-1657 shot 80 qts making 150 bbls in Bville sand.

Form 26—1M—4-19—Mid-West

Map No. K17 Sec. 10 Twp. 23 R. 13


Well No. 3 L. Snider

Tuta Company

Contractor

FIRST REPORT

SECTION PLAT

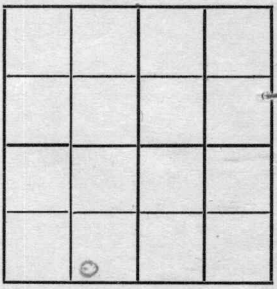

200 Ft. from N. Line

Ft. from S. Line

1120 Ft. from E. Line

Ft. from W. Line

Location

Rig up

Drilling and Remarks:

40. 700

RECORD

Cased in., ft.

Sand

Gas

Oil

Total Depth

PRODUCTION

1st 24 hrs. Nat.

1st 24 hrs. after shot

Gas Cu. Ft.

Dry Hole

Abandoned

Date

FEB 8 1 1922

191

M. A. BENEAR

Scout

Form 26—1M—4-19—Mid-West

Map No. K17 Sec. 10 Twp. 25 R. 13

Well No. 3 Schneider


Sheta

Company

Contractor

COMPLETED

SECTION PLAT

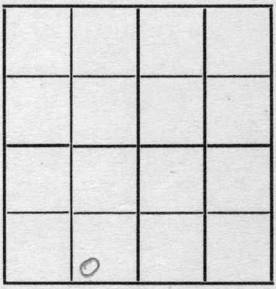

200 Ft. from N. Line

Ft. from S. Line

1120 Ft. from E. Line

Ft. from W. Line

Location

Rig up

Drilling and Remarks:

sand 1627-1657
shot. 80 qts.
Making 150 bbls
This is Swill
sand.

RECORD

Cased in., ft.

Sand

Gas

Oil

Total Depth

PRODUCTION

1st 24 hrs. Nat.

1st 24 hrs. after shot

Gas Cu. Ft.

Dry Hole

Abandoned

Date

MAR 1 2 1922 191

M. A. BENEAR

Scout