

SEC.	TWP.	R.
29	28	1 E

WELL NO.

1 Jeffries

FARM

COMPANY

Adair Oil

CONTRACTOR


Co. tools
Gladys Pool~~330~~ Ft. from N. Line

30 Ft. from S. Line

Ft. from E. Line

~~300~~
~~330~~ Ft. from W. Line~~NW NW SW~~

SW SW NW

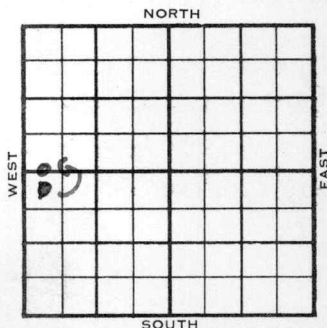

1955

ELEVATION

1267'

REPORT

1/26

Spud 1-19-55

8" @ 151'

Drlg. 1798'

2/23

Spud 1-19-55 - Oil Well

TD 3153'

8" @ 151'

Heeb. 2043', Lans. 2273', Stal. 2282,

KC 2629', B KC 2820', Miss 3121',

Dolo 3126'

TD 3142'

DD 3153'

5" @ 3127', 2000A

Comp. F/441 bopd

COMPLETED

SCOUT TICKET

DX-201

SEC.	TWP.	R.
29	28	1E

WELL NO.

1 Jeffries

FARM

COMPANY

Adair Oil

CONTRACTOR

CORRECTION


SW SW NW

_____ FT. FROM N. LINE

30 _____ FT. FROM S. LINE

_____ FT. FORM E. LINE

300 _____ FT. FROM W. LINE

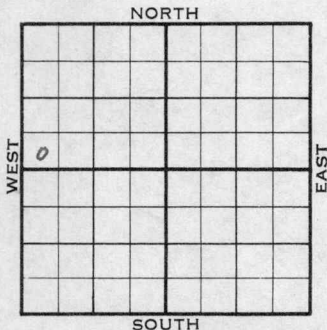

Sedgwick County

LOCATION

RIG UP

DRILLING AND REMARKS:

Reported
NW NW SW

RECORD

CASED IN., FT.

SAND

GAS

OIL

TOTAL DEPTH

PRODUCTION

1ST 24 HRS. NAT.

1ST 24 HRS. AFTER SHOT

GAS CU. FT.

DRY HOLE

ABANDONED

DATE

FEB 2 1955

SCOUT

ABEN GILSTRAP

