


Map No. _____ Sec. 29 Twp. 28 R. 1E
 Well No. T. C. Johnson & Atlantic Farm _____ Company _____

NORTH

WEST

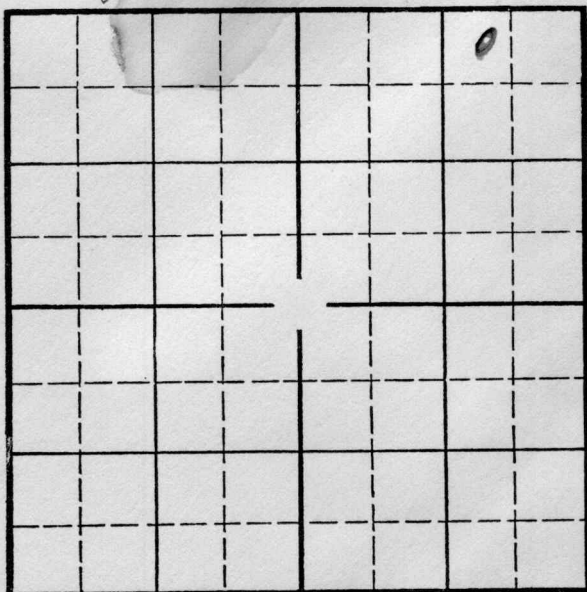

EAST

SOUTH

Location _____
 Drilling Remarks _____

Rig Up _____
 Drilling Remarks _____

RECORD

Cased _____ in. _____ ft.
 Sand _____
 Gas _____
 Oil _____
 Total Depth _____

PRODUCTION

1st 24 hrs. Nat. _____
 1st 24 hrs. after shot _____
 Gas _____ cu. ft.
 Dry Hole _____
 Abandoned _____

Map No. KANSAS Sec. 29 Twp. 28 R. 1E
Well No. 1 Jones Estate Farm
T. C. Johnson & Atlantic Company


330 Ft. from N. Line

_____ Ft. from S. Line

990 Ft. from E. Line

_____ Ft. from W. Line

Elev. 1270

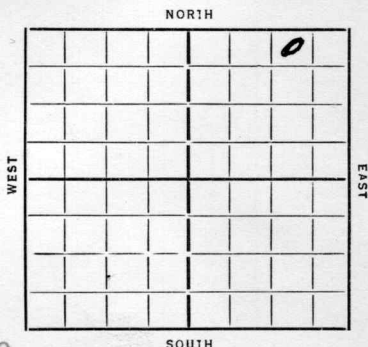

Date 1935 REPORT

8/14 Location
8/22 10" 92 woc
8/29 dly 1475
9/6 10/3—
10/10 dly 3177
10/17 Oil 3112-16 A.O.
TD 3177
2000 acid
D & A.

ABANDONED

Bedford *KANSAS*
 Map No. 12 Sec. 29 Twp. 28 R. 1E

Well No. 1- Jones Estate

T. C. Johnson & Atlantic Company

Contractor

FIRST REPORT

SECTION PLAT

			①

330 Ft. from N. Line

Ft. from S. Line

990 Ft. from E. Line

Ft. from W. Line

FIRST REPORT

Location ✓

Rig up

Drilling and Remarks:

RECORD

Cased in., ft.

Sand

Gas

Oil

Total Depth

PRODUCTION

1st 24 hrs. Nat.

1st 24 hrs. after shot

Gas Cu. Ft.

Dry Hole

Abandoned

Date

8-14-35 192

ORVAL MANNSCHRECK

Scout

Map No. 12 Sec. 29 Twp. 28 R. 1 EWell No. 1- Jones Est.Johnson + Atlantic Company

Contractor

ABANDONED

SECTION PLAT

330 Ft. from N. Line

Ft. from S. Line

990 Ft. from E. Line

Ft. from W. Line

			0

Location.....

Rig up.....

Drilling and Remarks:

2000 and10 + A

RECORD

Cased.....in.,ft.

Sand.....

Gas.....

Oil 3112-16 A.O.Total Depth 3177

PRODUCTION

1st 24 hrs. Nat.....

1st 24 hrs. after shot.....

Gas.....Cu. Ft.

Dry Hole.....

Abandoned.....

Date

10-17-35 192.....Scout

ORVAL MANNSCHRECK