


Section 6 Township 27 Range 4E

Well No. #1 Corbin

Company C. L. Carlock

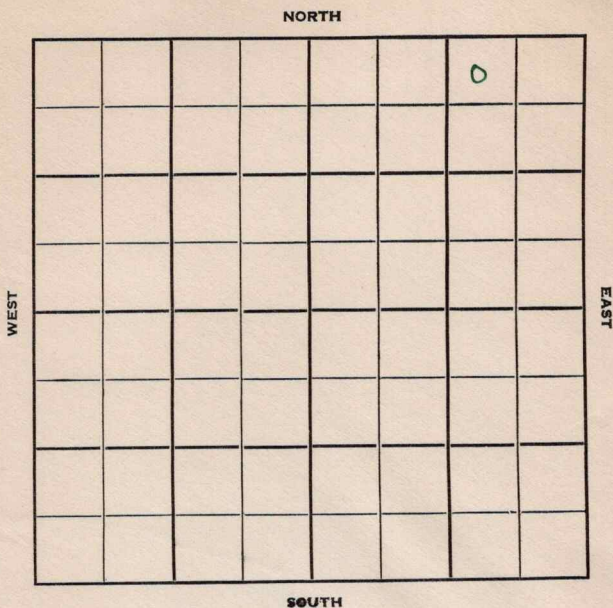

Butler

KANSAS

Sec. 6 Twp. 27 R. 4E

Well No. #1 Corbin Farm

C. L. Carlock Company

Morrison Contractor


330 Ft. from N. Line

 Ft. from S. Line

990 Ft. from E. Line

 Ft. from W. Line

NW NE NE

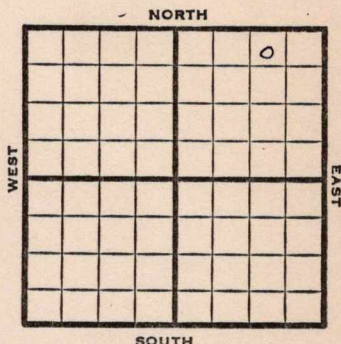

1951

Elev. 1275'

REPORT


11/28

Spud 11-21-51
8" @ 86'
Drlg. 1500'

12/5

Spud 11-21-51
D & A TD 3035' 8" @ 86
Miss 2655' B. Miss 2852'
Viola 2918'
DST 2919-30 open 45 min. rec water.
Simp. 2933' Arb. 3031-35' TD
D & A

ABANDONED

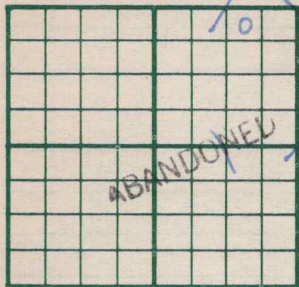County Butler State KansasSec. 6 (Blk.
Twp.) 27 (Sur.
Rge.) 4E Map No.Operator C. L. CarlockWell No. 1 Farm CorbinElev. 1275 Location NW NE NE330 Ft. From N Line NE990 Ft. From E Line Quarter

1st. Report

Completion DEC 5 1951

Remarks

Morrison Drlg. - Contr.Spudding Date 11-21-51Drlg. Data D & A TD 30358" @ 86 Miss. 2655 B. Miss. 2852Viola 2918 DST 2919-30 open 45 min.Rec. water Simp. 2933 Arb. 3031-35 TDD & A

J. E. TYRA