

KANSAS

Butler


Section 6 Township 27 Range 4EWell No. #1 CorbinCompany E AdairMiscellaneous

NORTH

WEST

EAST

SOUTH

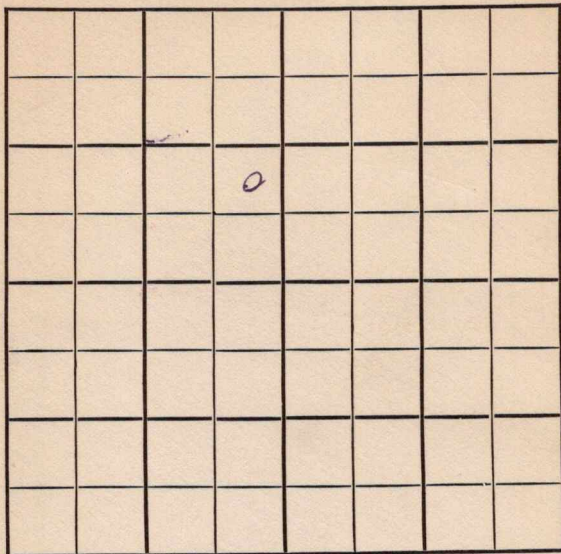

KANSAS

Sec. 6 Twp. 27 R. 4E

Well No. #1 Corbin Farm

E. Adair Company

Misc.


 Ft. from N. Line

990 Ft. from S. Line

330 Ft. from E. Line

 Ft. from W. Line

NE SE NW

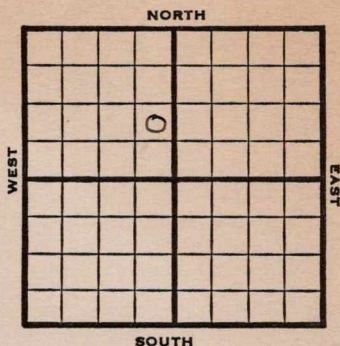

1948

Lev. 1302'

REPORT

4/21 Machine

4/28 Spud.

5/5 15" @ 110'
Drlg. 815'

5/12 13" @ 855'
Drlg. 1580'

5/19 10" @ 1843'
Lansing 1975'
Drlg. 2075'

5/26 Drlg. 2285'

6/1 8" @ 2298'
Drlg. 2640'

6/9 Viola 2935'
6" @ 2700'
5" @ 2935'
Pump 25 oil pot
38.0 Gr.
TD 2938'
Comp.

COMPLETED

Map No. _____ Sec. 6 Twp. 27 R. 4E

Well No. 1 Corbin


E. Adair Company

FIRST REPORT

Contractor

NE SE NW

SECTION PLAT

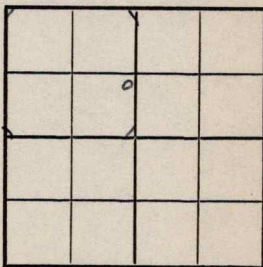

_____ Ft. from N. Line

990 Ft. from S. Line

330 Ft. from E. Line

_____ Ft. from W. Line

Butler County

Location _____

Rig up _____

Drilling and Remarks:

Machine

RECORD

Cased _____ in., _____ ft.

Sand _____

Gas _____

Oil _____

Total Depth _____

PRODUCTION

1st 24 hrs. Nat. _____

1st 24 hrs. after shot _____

Gas _____ Cu. Ft.

Dry Hole _____

Abandoned _____

Date

APR 21 1948 19

S. J. LEWIS Scout

Map No. 11 Sec. 6 Twp. 27 R. 4EWell No. 1 CorbinE. Adair Company

COMPLETE

Contractor

NE SE NW

E, 1302
SECTION PLAT

	6		

 Ft. from N. Line990 Ft. from S. Line330 Ft. from E. Line Ft. from W. Line

Butler County

Location Rig up

Drilling and Remarks:

Vid 29356" @ 27005" @ 2935Pump 25 oil 1st35 = 1st

RECORD

Cased in., ft.Sand Gas Oil Total Depth 2935

PRODUCTION

1st 24 hrs. Nat. 1st 24 hrs. after shot Gas Cu. Ft.Dry Hole Abandoned

Date

JUN 9 1948 19 S. J. LEWIS Scout