


Section 29 Township 28 Range 1EWell No. 1 Munson UnitCompany Petroleum Inc.

NORTH

WEST

EAST

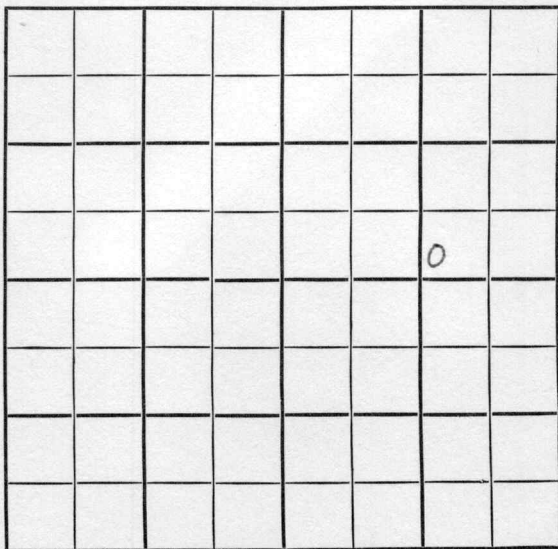

SOUTH

Sedgwick

KANSAS

SEC.	TWP.	R.
29	28	1E

WELL NO.

#1 Munson Unit

FARM

COMPANY

Petroleum Inc.

CONTRACTOR

Rig #9 Garvey

Gladys

2277

Ft. from N. Line


Ft. from S. Line

1083

Ft. from E. Line

Ft. from W. Line

SW SE NE

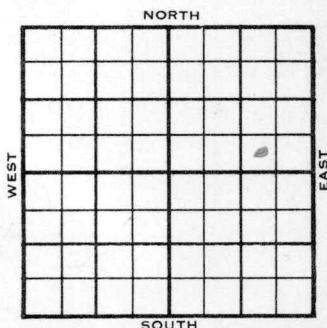

	ELEVATION	REPORT
1955	1272'	
7/20	Comm 7-13-55 8" 146 w/175 D 2785	
9-21	5½" @ 3190 w/75; flo 3 boph 40/3140-50; Swb 3/4 bfph 36% oil; PB 3130 60/3118-28; 1000 A; flo 3½ boph; 3000 A; flo 3½ boph no wtr.; flo pot. 18 bopd no wtr. Tops: K.C. 2632 Cht 3104 Dolo 3116 T.D. 3192'	

COMPLETED

County Sedgwick Elev. _____
 Sec. 29 Twp. 28 Rge. 1E
 Company Petroleum Inc.
 Farm Name Munson Unit No. 1

TOPS

DEPTH

LOG

DATUM

Loc. in Sec. _____

Anh.

Tp.

H.

Tr.

Dg.

BL.

L.

K.C.

B.K.C.

Ce.

C.

M.

M.

K.

Mz.

Mq.

V.

S.

S.

A.

R.

PE.

G.

T.D.

SW SE NE

2277 FNL x

1083 FEL NE/4

Geol. _____

Contr. Rig #9Garbey

Pool

Gladys

FIRST REPORT

JUL 20 '55

Date Comm. 7/13/55
8" 146 w/175 D 2785

Co.

Lse.

No.

Sec.

T.

R.

County Sedgwick Elev. 1272 Co. 1
 Sec. 29 Twp. 28S Rge. 1E
 Company Petroleum, Inc.
 Farm Name Munson Unit No. 1

TOPS	DEPTH	LOG	DATUM	Loc. in Sec.
Anh.				SW SE NE
Tp.				2277 FNL x
H.				1083 FEL NE/4
Tr.				
Dg.				
Bl.				
L.				
K.C.	2632		1360	Geol. <u>Rig #9</u>
B.K.C.				Contr. <u>Garvey</u>
Ce.				Pool <u>Gladys</u>
C. <u>Cht</u>	3104		1832	COMPLETE
M. <u>Dolo</u>	3116		1844	
K.				
Mz.				
Me.				
V.				
S.				
S.				
A.				
R.				
Pe.				
G.				
T.D.	3192			

Date Comm. 7-13-55 SEP 21 1955

8" 146 w/175; 5 $\frac{1}{2}$ " 3190 w/75; flo 3 boph

40/3140-50; swb 3/4 bfph 36% oil; PB 3130

60/3118-28; 1000 A; flo 3 $\frac{1}{2}$ boph; 3000 A;

flo 3 $\frac{1}{2}$ boph no wtr.; flo pot. 18 bopd

no wtr.