


Map No. **KANSAS** Sec. *6* Twp. *27* R. *4E*

Well No. *1-Corbin* Farm

Sidal Oil Company

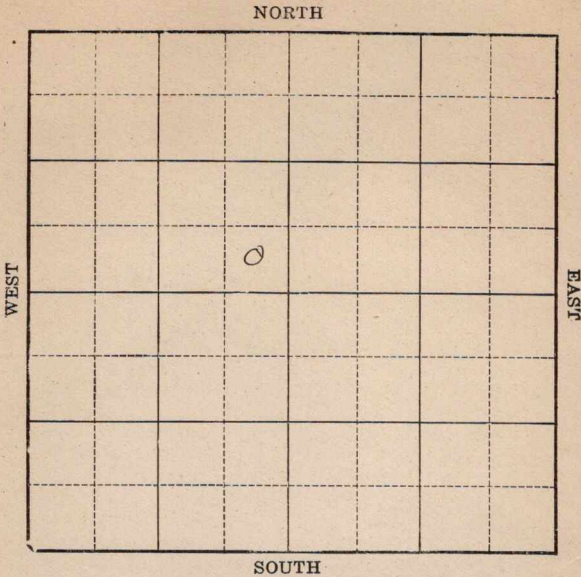

Location _____

Drilling Remarks _____

Rig Up _____

Drilling Remarks _____

RECORD

Cased _____ in. _____ ft.

Sand _____

Gas _____

Oil _____

Total Depth _____

PRODUCTION

1st 24 hrs. Nat. _____

1st 24 hrs. after shot _____

Gas _____ cu. ft.

Dry Hole _____

Abandoned _____

Map No. **KANSAS** Sec. 6 Twp. 27 R. 4^E

Well No. 71- Carbin Farm


Tidal Oil Company

Ft. from N. Line

330 Ft. from S. Line

330 Ft. from E. Line

1930 Ft. from W. Line

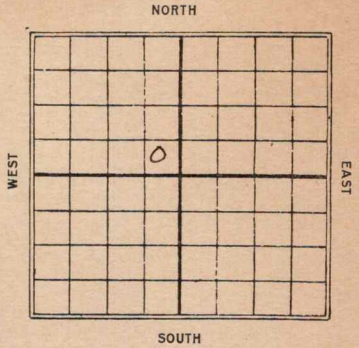

Date

REPORT

Date	REPORT
4/30	Loc.
5/7	Roll
5/14	
5/21	Rig
5/28	hrlg. 700'
6/4	" 1370'
6/11	" 2040'
6/18	" 2100'
6/25	10" - 2144'
	hrlg. 2223'
7/2	10" - 2306'
	hrlg. 2310'
7/9	" 2700'
7/16	Setg 6" - 2884'
7/23	Safed 2917-2919; swabbed 132 bbls in 4 hrs. rmg. tubing.
7/30	Sand 2917-2919 TD 2919 762 bbl oil - 25° grav Comp.

Butler

KANSAS

Map No. 11 Sec. 6 Twp. 27 R. 4^E

Well No. 1 Carbin

Jidal Oil Co Company

Contractor

FIRST REPORTS

SECTION PLAT

..... Ft. from N. Line

330 Ft. from S. Line

330 Ft. from E. Line

..... Ft. from W. Line

	0		

Location ✓

Rig up

Drilling and Remarks:

RECORD

Cased..... in., ft.

Sand.....

Gas.....

Oil.....

Total Depth.....

PRODUCTION

1st 24 hrs. Nat.....

1st 24 hrs. after shot.....

Gas..... Cu. Ft.

Dry Hole.....

Abandoned.....

Date

APR 30 1930

192..... Scout

CHAS. L. SHERWOOD

Butler

Map No. **KANSAS** Sec. 6 Twp. 27 R. 4

Well No. 1 Corbin

Ideal Oil Co Company

Contractor

COMPLETE

SECTION PLAT

_____ Ft. from N. Line

330 Ft. from S. Line

330 Ft. from E. Line

_____ Ft. from W. Line

Location _____

Rig up _____

Drilling and Remarks:

762 Bls.

75 gravity

RECORD

Cased _____ in., _____ ft.

Sand 2917 - 2919

Gas _____

Oil _____

Total Depth 2919

PRODUCTION

1st 24 hrs. Nat. _____

1st 24 hrs. after shot _____

Gas _____ Cu. Ft.

Dry Hole _____

Abandoned _____

Date

JUL 30 1930

19

CHAS. L. SHERWOOD

Scout