
DX 78-1

Sedgwick KANSAS

Section 29 Township 28S Range 1E

Well No. 2 Parton

Company F. Raymond

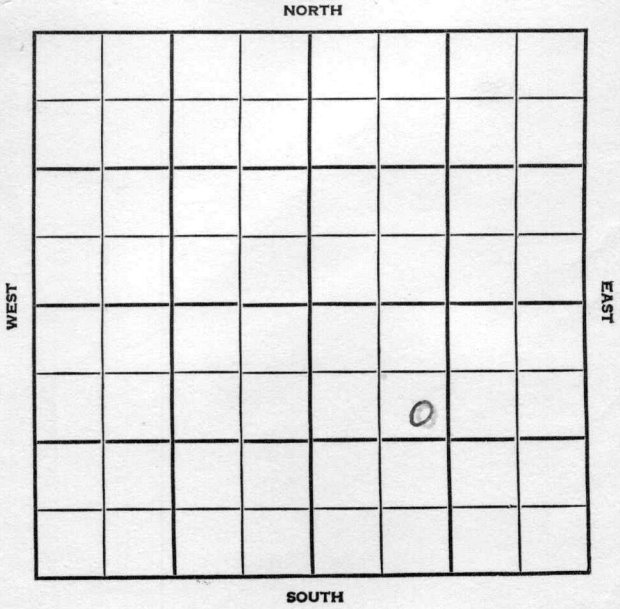

Sedgwick KANSAS

SEC.	TWP.	R.
29	28S	1 E

WELL NO.

#2 Parton FARM
COMPANY

F. Raymond
CONTRACTOR

Murfin

Gladys


_____ Ft. from N. Line

_____ Ft. from S. Line

_____ Ft. from E. Line

_____ Ft. from W. Line

SE NW SE

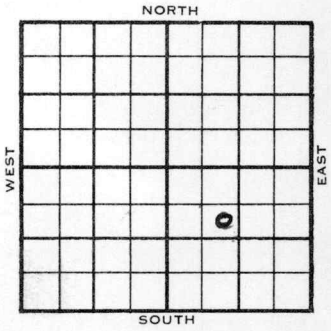

1955	ELEVATION 1270'	REPORT
7/6		Comm 6-2-55; 8" 158; D 1342
8-24		5½" @ 3197, CO to 3197,DD 3220, PB 3190, 30/ 3172-77, 30/ 3155-65 30/ 3141-49, S/ 20 boph, 3 hr. 250 A. F/ 50 boph 6 hr., F/ 70 boph, 1 hr. Comp. F/ 966 bopd. Tp. Stal.,2291,1021,K.C. 2622,1352 M.Chert,3117,1847,M. Dolo 3138,1868 T.D. 3197

COMPLETED

DX-78

FORM 513 REV. SUNRAY

County Sedgwick Elev.

Sec. 29 Twp. 28S Rge. 1E

Company F. Raymond

Farm Name Parton No. 2

TOPS	DEPTH	LOG	DATUM
Anh.			
Tp.			
H.			
Tr.			
Dg.			
B.L.			
L.			
K.C.			
B.K.C.			
Ce.			
C.			
M.			
M.			
K.			
Mz.			
Mo.			
V.			
S.			
S.			
A			
R.			
P€.			
G.			
T.D.			

Loc. in Sec. SE NW SE

Geol.

Contr. Murfin

Pool Gladys



Date Comm. 6-2-55; 8" 158; D 1342

Co. Lse. No. Sec. T. R.

FORM 513 REV. SUNRAY

County Sedgwick Elev. 1270

Sec. 29 Twp. 28 Rge. 1E

Company F. Raymond

Farm Name Parton No. 2

TOPS	DEPTH	LOG	DATUM
Anh.			
Tp. Stal	2291		1021
H.			
Tr.			
Dg.			
B.L.			
L.			
K.C.	2627		1352
B.K.C.			
Ce.			
C.			
M. chert	3117		1847
M. Dolo	3138		1868
K.			
Mz.			
Mq.			
V.			
S.			
S.			
A			
R.			
P€.			
G.			
T.D.	3197		

Loc. in Sec. SE NW SE

Geol.

Contr. Murfin

Pool Gladys

COMPLETE

Date Comm. 6-2-55

AUG 24 1955

8" @ 158 5½" @ 3197 CO to 3197

DD 3220 PB 3190 30/ 3172-77 30/ 3155-65 30/ 3141-49 S/ 20 boph 3 hr.

250 A F/ 50 boph 6 hr. F/ 70 boph 1 hr. Comp. F/ 966 bopd

Co. Lse. No. Sec. T. R.