


Map No. KANSAS Sec. 6 Twp. 27 R. 4^E
 Well No. 1 GELWICKS Farm
Sullivan & Melrose Company

NORTH

WEST

EAST

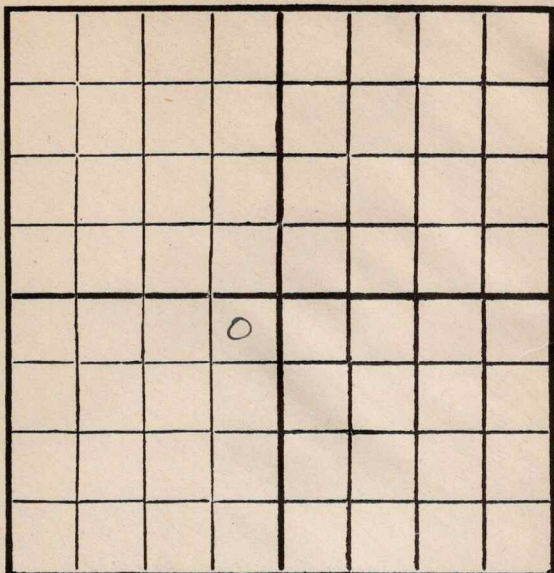

SOUTH

Location _____

Drilling Remarks _____

Rig Up _____

Drilling Remarks _____

RECORD

Cased _____ in. _____ ft.

Sand _____

Gas _____

Oil _____

Total Depth _____

PRODUCTION

1st 24 hrs. Nat. _____

1st 24 hrs. after shot _____


Gas _____ cu. ft.

Dry Hole _____

Abandoned _____

Map No. 1251 **KANSAS** Sec. 6 Twp. 27 R. 4^E
Well No. 1 ~~Florence~~ **GELWICK** Farm
Sullivan & Melrose Company

330 Ft. from N. Line
Ft. from S. Line
330 Ft. from E. Line
Ft. from W. Line

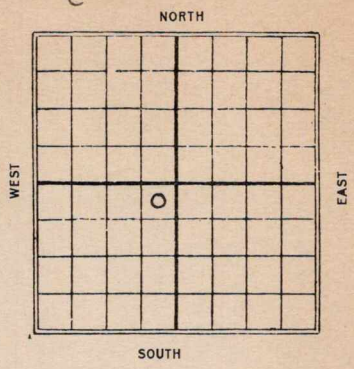

1929

Date	REPORT
10/9	Ry
10/16	Spdy & SD
10/23	
10/30	—
11/6	—
11/13	—
11/20	—
11/27	—
12/4	—
12/11	—
12/23	—
12/30	—
1930	
1/8	—
1/15	
1/22	Drlg 675'
1/29	SD 675'
2/4	Drlg. 1050
2/11	" 1465'
2/19	" 2153' - N 7 W
2/26	" 2285' 8" - 2280'
3/5	" 2395'

- 3/2 - Log. 8" - 2447' 757579
3/18 - —
3/26 —
4/2 - Wdly. 2675'
4/9 - Top lime 2717' AFW
2722-28 Wdly. 2770
4/16 - Base 2858' AFW.
Top Wilcox 2924-27'
show oil thru AFW
Reg. 5"
4/23 - Viola 2924-2927
Swabbed 360 bbls in
20 hours - 27 Grav.
4/30 - Top lime 2717-2858
Sand 2924-27
TD. 2927
380 bbl oil
28° grav.
Pump.

Butler

Map No. **KANSAS** Sec. 6 Twp. 27 R. 4^E
 Well No. 1 Florence
Sullivan & Melrose Company

Contractor

FIRST REPORTS**SECTION PLAT**

	9		

330 Ft. from N. Line

_____ Ft. from S. Line

330 Ft. from E. Line

_____ Ft. from W. Line

Location _____

Rig up ☒

Drilling and Remarks:

RECORD

Cased _____ in., _____ ft.

Sand _____

Gas _____

Oil _____

Total Depth _____

PRODUCTION

1st 24 hrs. Nat. _____

1st 24 hrs. after shot _____

Gas _____ Cu. Ft.

Dry Hole _____

Abandoned _____

Date

OCT 9

1929

CHAS. L. SHERWOOD

19

Scout

Butler

Map No. 11 **KANSAS** Sec. 6 Twp. 27 R. 4 ^E

Well No. 1 Selwick
Sullivan & Melrose Company

Contractor

CORRECTION

SECTION PLAT

330 Ft. from N. Line

_____ Ft. from S. Line

330 Ft. from E. Line

_____ Ft. from W. Line

Location _____

Rig up _____

Drilling and Remarks:

Chy Farm name

RECORD

Cased _____ in., _____ ft.

Sand _____

Gas _____

Oil _____

Total Depth _____

PRODUCTION

1st 24 hrs. Nat. _____

1st 24 hrs. after shot _____

Gas _____ Cu. Ft.

Dry Hole _____

Abandoned _____

Date

OCT 16 1929

192

CHAS. L. SHERWOOD

Scout

Butler

Map No. **KANSAS** Sec. 6 Twp. 27 R. 4Well No. 1 GelwickSullivan & Melrose Company

Contractor

COMPLETE

SECTION PLAT

330 Ft. from N. Line

Ft. from S. Line

330 Ft. from E. Line

Ft. from W. Line

	0		

Location

Rig up

Drilling and Remarks:

TL 2717-2858

380 Bls.

28 gravity

RECORD

Cased _____ in., _____ ft.

Sand 2924-2927

Gas _____

Oil _____

Total Depth 2927

PRODUCTION

1st 24 hrs. Nat. _____

1st 24 hrs. after shot _____

Gas _____ Cu. Ft.

Dry Hole _____

Abandoned _____

Date

APR 30 1930

192

CHAS. L. SHERWOOD

Scout