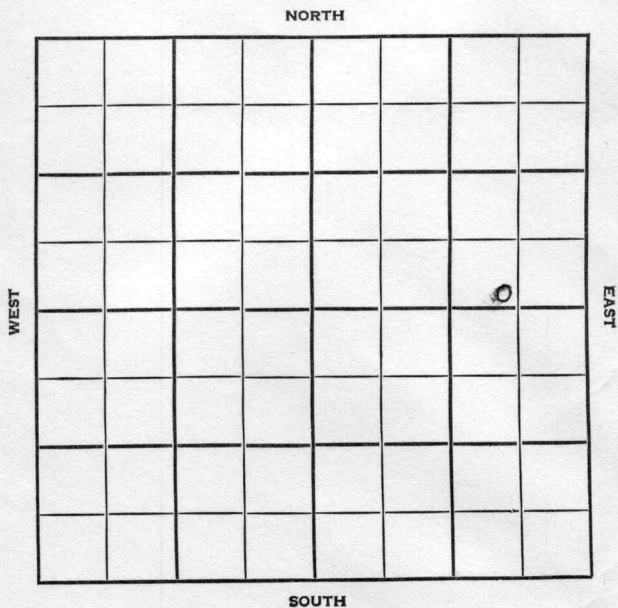


Section 29 Township 28 Range 1 EWell No. #1 Sommer-HouserCompany O. A. Sutton

Sedgwick

KANSAS

SEC.	29	TWP.	28	R.	1E
------	----	------	----	----	----

WELL NO.

#1 Sommer-Houser

FARM

COMPANY

O. A. Sutton

CONTRACTOR

Renfro Drlg.

Gladys


_____ Ft. from N. Line

_____ Ft. from S. Line

_____ Ft. from E. Line

_____ Ft. from W. Line

SE SW SE NE

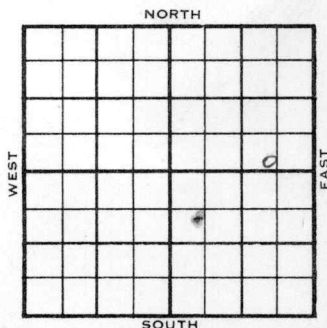

1955

ELEVATION

1271'

REPORT

8/24

Cellar & Pits

9-21

Comm. 8-23-55

8 5/8" @ 143 w/160

D & A

Tops: K.C. 2617

Cht. 3133

Ls. 3156

T.D. 3225'

ABANDONED

Sedgwick

Elev.

Sec.

29

Twp.

28

Ree.

7E

Company

O. A. Sutton

Farm Name

Sommer-Houser

No.

7

TOPS	DEPTH	LOG	DATUM
Anh.			
TP.			
H.			
Tr.			
Dg.			
BL.			
L.			
K.C.			
B.K.C.			
Ce.			
C.			
M.			
M.			
K.			
Mz.			
Mq.			
V.			
S.			
S.			
A			
R.			
PE.			
G.			
TD.			

Loc. in Sec.

~~SE SW SE NE~~

Geol.

Centr

Renfro Drlg.

Pool

Gladys

FIRST REPORT

AUG 24 1965

Date Comm.

Cellar & pits

Co.

Use

No.

Sec.

T.

五

County	Sedgwick	Elev.	1271	Co.
Sec.	29	Twp.	28S	
Company	O. A. Sutton	Rge.	1E	
Farm Name	Sommer-Houser	No.	1	

TOPS	DEPTH	LOG	DATUM	Loc. in Sec.	Lse.
Anh.				SE SW SE NE	
Tr.					
Dg.					
B.L.					
L.					
K.C.	2617		1346	Geol.	
B.K.C.				Contr.	
Ce.				Renfro Drlg.	
C.				Pool	
M. Cht.	3133		1862	Gladys	
M. Ls.	3156		1885		
K.					
Mz.					
Mq.					
V.					
S.					
S.					
A.					
R.					
Pe.					
G.					
T.D.	3225				

Date Comm.	8-23-55	SEP 21 1955	No.
8-5/8" 143 w/160; D & A			
			Sec.
			T.
			R.