KANSAS


Sedgwick

DX 78-1

Section 29 Township 28 Range 1E

Well No. 2 Vaupel

Company E. H. Adair

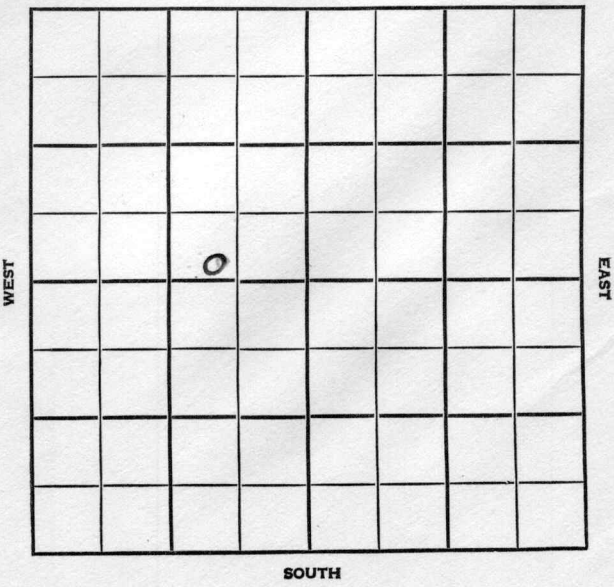

Sedgwick KANSAS

SEC.	TWP.	R.
29	28	1E

WELL NO. 2 Vaupel FARM

COMPANY E. H. Adair

CONTRACTOR Co. Tools
Gladys


_____ Ft. from N. Line

230 Ft. from S. Line

928 Ft. from E. Line

_____ Ft. from W. Line

SW SE NW

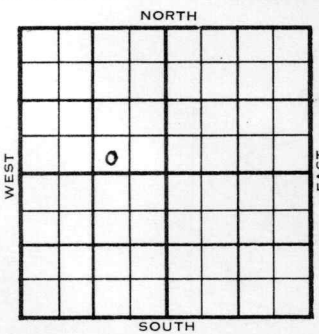

1955 ELEVATION 1267 REPORT

6/22 Drlg 2000
8/3 Comm. 6-19-55
8 5/8" @151
5½" @3125 TD 3178 130/3130-65 3000A
F/60 boph Comp 326 bopd
KC 2625 1358
M. Dolo 3125 1858
TD. 3178

COMPLETED

DX-78

FORM 513 REV. SUNRAY

County Sedgwick Elev.

Sec. 29 Twp. 28 Rge. 1E

Company E. H. Adair

Farm Name Vaupel No. 2

TOPS	DEPTH	LOG	DATUM
Anh.			
Tp.			
H.			
Tr.			
Dg.			
B.L.			
L.			
K.C.			
B.K.C.			
Ce.			
C.			
M.			
M.			
K.			
Mz.			
Mo.			
V.			
S.			
S.			
A			
R.			
P€.			
G.			
T.D.			

Loc. in Sec.

SW SE NW

230' SL

928' EL

Geol.

Contr.

Co. tools

Pool

Gladys

JUN 22 '55

FIRST REPORT

Date Comm.

drlg. 2000

Co. Lse. No. Sec. T. R.

FORM 513 REV. SUNRAY

County Sedgwick Elev. 1267

Sec. 29 Twp. 28 Rge. 1E

Company E. H. Adair

Farm Name Vaupel No. 2

TOPS	DEPTH	LOG	DATUM
Anh.			
T.p.			
H.			
Tr.			
Dg.			
B.L.			
L.			
K.C.	2625		1358
B.K.C.			
Ce.			
C.			
M. Dolo	3125		1858
M.			
K.			
Mz.			
Mq.			
V.			
S.			
S.			
A			
R.			
P€.			
G.			
T.D.	3178		

Loc. in Sec. SW SE NW

230' SL

928' EL

Geol.

Contr. Co. tools

Pool Gladys

6

COMPLETE

AUG 3 1955

Date Comm. 6-19-55

8 5/8" @ 151 $5\frac{1}{2}$" @ 3125 T^D 3178

130/ 3130-65 3000 A F/ 60 boph

Comp. 326 bopd

Co. Lse. No. Sec. T. R.