

Map No. KANSAS Sec. 29 Twp. 28 R. 1E

Well No. 1-1 Ford Ford Farm

M. J. Sullivan et al Company

NORTH

(Worford)

WEST

EAST

			0				

SOUTH

Location.....

Drilling Remarks

.....

.....

Rig Up.....

Drilling Remarks

.....

.....

RECORD

Cased..... in..... ft.

Sand.....

Gas.....

Oil.....

Total Depth.....

PRODUCTION

1st 24 hrs. Nat.....

1st 24 hrs. after shot.....

Gas..... cu. ft.....

Dry Hole.....

Abandoned.....

Sedgwick
 Map No. KANSAS Sec. 29 Twp. 28 R. 1^E
 Well No. 17 *Woodford* Farm
M. J. Sullivan et al Company


330 Ft. from N. Line

_____ Ft. from S. Line

_____ Ft. from E. Line

1815 Ft. from W. Line

1929

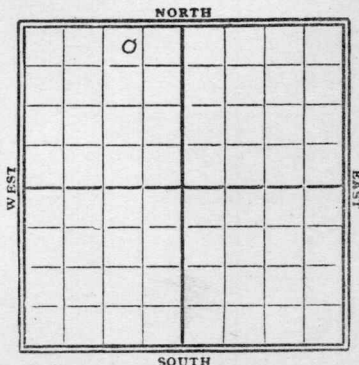

Date	REPORT
5/22	Bldg Rig 10 H. track
5/29	Spur 2
6/5	Wrlg 655
6/12	" 1190'
6/19	" 1955
6/26	" 2200
7/2	2300 - W.R. 10"
7/10	fgg tools 2350'
7/17	
7/24	Wrlg 2400'
7/31	" 2718
8/7	" 3082'
8/14	g-p chat 3126 show oil T.D. 3140 - W.R. 8"
8/21	Wrlg 3245'
8/28	Top Viola 3524'
	HFW - 3601-06'
	ID 3606'
	Abandoned

Map No. KANSAS Sec. 29 Twp. 28 R. 1E

Well No. 1404 Ford

H. J. Sullivan & Co. Company

Contractor

SECTION PLAT

830 Ft. from N. Line

..... Ft. from S. Line

..... Ft. from E. Line

1875 Ft. from W. Line

	0		

FIRST REPORTS

Location.....

Rig up.....

Drilling and Remarks:

*Building rig
have 10 acres.*

RECORD

Cased..... in., ft.

Sand.....

Gas.....

Oil.....

Total Depth.....

PRODUCTION

1st 24 hrs. Nat.....

1st 24 hrs. after shot.....

Gas..... Cu. Ft.

Dry Hole.....

Abandoned.....

Date

MAY 22 1929

192.....

S. J. LEWIS

Scout

Map No. 12 KANSAS Sec. 29 Twp. 28 R. 1E

Well No. 14 dealy deat

M. J. Sullivan & Co. Company

Contractor

SECTION PLAT

330 Ft. from N. Line

..... Ft. from S. Line

..... Ft. from E. Line

185 Ft. from W. Line

ABANDONED

	0		

Location.....

Rig up.....

Drilling and Remarks:

Top Viola 3524
NFW 3601-06

RECORD

Cased.....in.,ft.

Sand.....

Gas.....

Oil.....

Total Depth 3606

PRODUCTION

1st 24 hrs. Nat.....

1st 24 hrs. after shot.....

Gas.....Cu. Ft.

Dry Hole.....

Abandoned.....

Date

AUG 28 1929
.....192.....

S. J. LEWIS Scout