


Section 11 Township 23 Range 13-EWell No. #1 HannenCompany Payrock Oil

NORTH

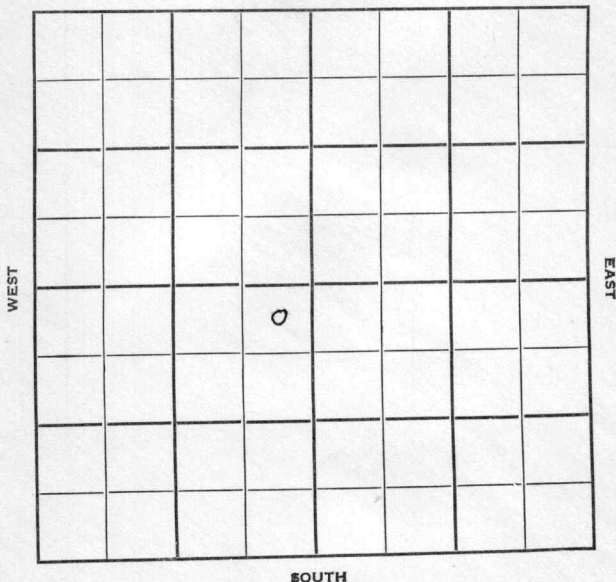

SOUTH

Coffey

KANSAS

Sec. 11 Twp. 23 R. 13E

Well No. #1 Hannen Farm

Payrock Oil Company

White & Ellis - Contr. Contractor


330' Ft. from N. Line

Ft. from S. Line

330' Ft. from E. Line

Ft. from W. Line

NE NE SW

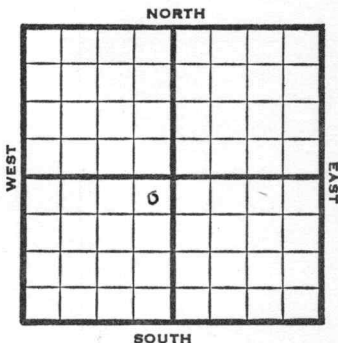

1950

?

REPORT

10/18 8" @ 87'
Drlg. 960'

12/20 8" @ 87'
Miss 1773
4" @ 1798
TD 1805
Comp 4 bopd
Completed
COMPLETED

County **Coffey** State **Kansas**

Sec. 11 (Blk. Twp.) 23 (Sur. Rge.) 13E Map No.

Operator **Payrock Oil**

Well No. **1** Farm **Hannen**

Elev.	Location	NE NE SW

330 Ft. From N Line SW

330 Ft. From ~~E~~ Line Quarter

1st. Report OCT 18 1950

Completion

Remarks


White & Ellis - Contr.

Spudding Date _____

Drlg. Data

8" @ 87 drlg. 960

J. E. TYRA

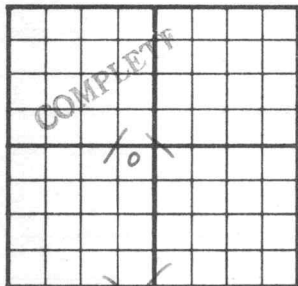County Coffey State KansasSec. 11 (Blk.) 23 (Sur.) 13E Map No.Operator Payrock OilWell No. 1 Farm HannenElev. Location NE NE SW330 Ft. From N Line SW330 Ft. From E Line Quarter1st. ReportCompletion DEC 20 1950RemarksWhite & Ellis - Contr.Spudding DateDrlg. Data Oilwell TD 18058" @ 87 Miss. 1773 4" @ 1798 TD 1805Comp. 4 bopd