


Map No. _____ Sec. 11 Twp. 23 R. 13
Well No. 2 - Hanner (Hannen) Farm
Sheedy et al Company
NORTH

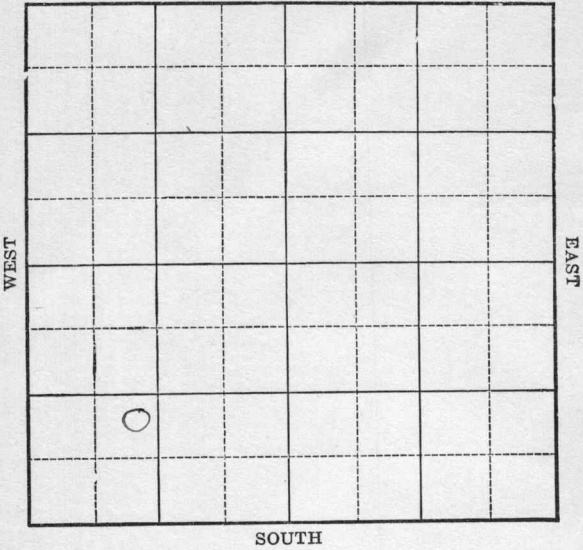

Location _____
Drilling Remarks _____

RECORD

Rig Up _____
Drilling Remarks _____

PRODUCTION


Cased _____ in. _____ ft.	1st 24 hrs. Nat. _____
Sand _____	1st 24 hrs. after shot _____
Gas _____	Gas _____ cu. ft.
Oil _____	Dry Hole _____
Total Depth _____	Abandoned _____

Map No. _____ Sec. 11 Twp. 23 R. 13Well No. 2-Hanner Farm
Sheedy et al Company

_____ Ft. from N. Line

1120 Ft. from S. Line

_____ Ft. from E. Line

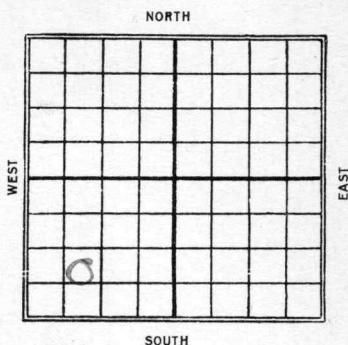1120 Ft. from W. Line

SOUTH

Date

REPORT

11/16 Top line 1756
 sdy. line and pay
 1762-1803
 30 bbls
 T.D. 1803'

17 **KANSAS** *Coffey*
 Map No. _____ Sec. *11* Twp. *23* R. *13*

Well No. *2* *Hanner* _____

Sheedy et al _____ Company

FIRST REPORTS

Contractor

COMPLETED

_____ Ft. from N. Line

1170 _____ Ft. from S. Line

_____ Ft. from E. Line

1170 _____ Ft. from W. Line

SECTION PLAT

<i>0</i>			

Location _____

Rig up _____

Drilling and Remarks:

Tap line 1756

Ady line 1756

Pay 1762-1803

20 Blo.

RECORD

Cased _____ in., _____ ft.

Sand _____

Gas _____

Oil _____

Total Depth *1803* _____

PRODUCTION

1st 24 hrs. Nat. _____

1st 24 hrs. after shot _____

Gas _____ Cu. Ft.

Dry Hole _____

Abandoned _____

Date

NOV 16 1927

192

CHAS. L. SHERWOOD

Scout