


Map No. _____ Sec. 11 Twp. 23 R. 13
Well No. 3 - Hanner Farm _____
Sheedy et al Company _____
NORTH (Hanner)

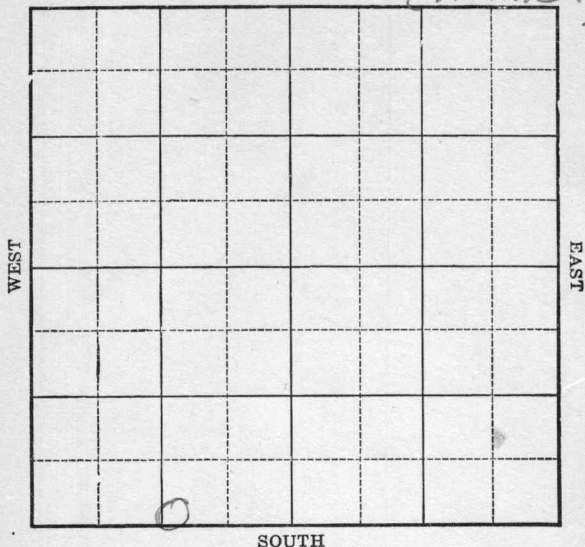

Location _____

Drilling Remarks _____

Rig Up _____

Drilling Remarks _____

RECORD

Cased _____ in. _____ ft.

Sand _____

Gas _____

Oil _____

Total Depth _____

PRODUCTION

1st 24 hrs. Nat. _____

1st 24 hrs. after shot _____

Gas _____ cu. ft.

Dry Hole _____

Abandoned _____

Map No. Kansas Sec. 11 Twp. 23 R. 13Well No. 3 - Hanner FarmWheddy et al Company

NORTH

Ft. from N. Line

150 Ft. from S. Line

Ft. from E. Line

1350 Ft. from W. Line

WEST

EAST

SOUTH

1927

Date

REPORT

11/16 Drlg 400'
11/23 " 1000'
11/30 " 1380'
12/7 " 1800 Top line
 Sand 1628-63 dry
12/14 1824-1850 T.O. 1850
 Dry sand 1628-63
 Top line 1800
 80/15 bbls

17 KANSAS Capper
 Map No. _____ Sec. 11 Twp. 23 R. 13
 Well No. 3 Banner
 Sheedy et al Company

Contractor _____

FIRST REPORTS

SECTION PLAT

_____ Ft. from N. Line

150 _____ Ft. from S. Line

_____ Ft. from E. Line

1350 _____ Ft. from W. Line

Location _____

Rig up _____

Drilling and Remarks:

RECORD

Cased _____ in., _____ ft.

Sand _____

Gas _____

Oil _____

Total Depth _____

PRODUCTION

1st 24 hrs. Nat. _____

1st 24 hrs. after shot _____

Gas _____ Cu. Ft.

Dry Hole _____

Abandoned _____

Date

NOV 16 1927

192

CHAS. L. SHERWOOD

Scout

17 KANSAS 11 Twp. 23 R. 13
 Map No. Sec. Twp. R.
 Well No. 3 Banner
 Sheedy & Co. Company
 Contractor

COMPLETED

SECTION PLAT

Ft. from N. Line

150 Ft. from S. Line

Ft. from E. Line

1350 Ft. from W. Line

Location

Rig up

Drilling and Remarks:

Dry to 1628-63

Top Line 1800

80y 15' Bl.

RECORD

Cased _____ in., _____ ft.

Sand 1824-1850

Gas _____

Oil _____

Total Depth 1850

PRODUCTION

1st 24 hrs. Nat. _____

1st 24 hrs. after shot _____

Gas _____ Cu. Ft.

Dry Hole _____

Abandoned _____

Date

DEC 14 1927

CHAS. L. SHERWOOD

192

Scout