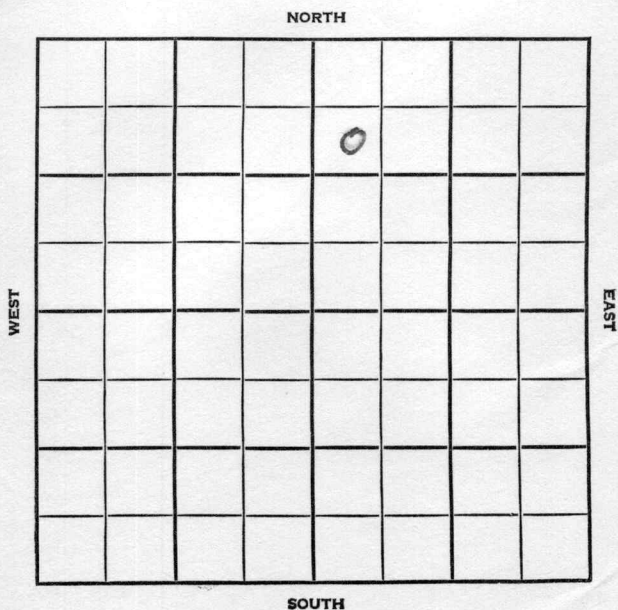


Section 30 Township 28S Range 1EWell No. 2 CookCompany E. H. Adair

Sedgwick		KANSAS	
SEC. 30	TWP. 28S	R. 1E	
WELL NO. #2 Cook			
COMPANY E. H. Adair			FARM
CONTRACTOR			

_____ Ft. from N. Line _____ Ft. from S. Line _____ Ft. from E. Line _____ Ft. from W. Line	WEST NORTH <table border="1" style="border-collapse: collapse; width: 100px; height: 100px; margin: 0 auto;"> <tr><td></td><td></td><td></td><td></td><td></td><td></td><td></td><td></td></tr> <tr><td></td><td></td><td></td><td></td><td>0</td><td></td><td></td><td></td></tr> <tr><td></td><td></td><td></td><td></td><td></td><td></td><td></td><td></td></tr> <tr><td></td><td></td><td></td><td></td><td></td><td></td><td></td><td></td></tr> <tr><td></td><td></td><td></td><td></td><td></td><td></td><td></td><td></td></tr> <tr><td></td><td></td><td></td><td></td><td></td><td></td><td></td><td></td></tr> <tr><td></td><td></td><td></td><td></td><td></td><td></td><td></td><td></td></tr> <tr><td></td><td></td><td></td><td></td><td></td><td></td><td></td><td></td></tr> </table> SOUTH EAST													0	
				0	

SW NW NE

1955	ELEVATION	REPORT
	1270'	
7/6	Comm. 6-28-55 8" 155; D 2815 K. C. 2629	
8/3	5 $\frac{1}{2}$ "@3126/100 CO to 3176 S/8 boph 2 hr 3000 A S/30 boph Comp. 120 bopd. KC 2629 1359 BKC 2815 1545 M. Dolo 3123 1853 TD 3176	COMPLETED

Elev.

Two.

288

Rec.

LE

Company E. H. Adair

Farm Name Cook

No. 2

TOPS	DEPTH	LOG	DATUM
Anh.			
Tp.			
H.			
Tr.			
Dg.			
B.L.			
L.			
K.C.	2629		
B.K.C.			
Ce.			
C.			
M.			
M.			
K.			
Mz.			
Me.			
V.			
S.			
S.			
A.			
R.			
Pc.			
G.			
I.D.			

Loc. in Sec. _____
SW NW NE

 Geol. _____
 Contr. _____

 Pool _____

0

FIRST REPORT

JUL 6 '55

Date Comm. 6-28-55; 8" 155; D 2815

Use

No.

Sec.

7.

五

County Sedgwick Elev. 1270
 Sec. 30 Twp. 28 Rge. 1E
 Company E. H. Adair
 Farm Name Cook No. 2

TOPS

DEPTH

LOG

DATUM

Loc. in Sec.

Anh.

SW NW NE

T.P.

H.

Tr.

Dg.

B.L.

L.

K.C.

2629

1354

Geol.

B.K.C.

2815

1545

Contr.

Ce.

C.

M.

D010

3123

1853

Pool

M.

K.

Mz.

Mq.

V.

S.

S.

A.

R.

P.E.

G.

T.D.

3176

COMPLETE

Date Comm. 6-28-55

AUG 3 1955

8" @ 155 5½" @ 3126/100 CO to 3176

S/ 8 boph 2 hr. 3000 A S/ 20 boph

Comp. 120 bopd