FORM 51 25M 3-49 PETROL


KANSAS

Coffey

Section 11 Township 23 Range 13-E

Well No. #1 Kufahl (Kufhal)

Company Pay Oil Co.

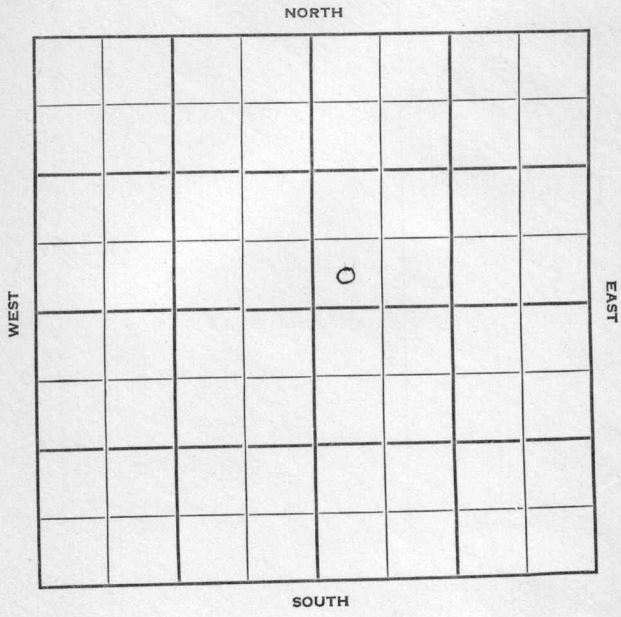

FORM 252-B
10M 9-49 PETROL

KANSAS

Coffey


Sec. 11 Twp. 23 R. 13E

Well No. #1 Kufahl Farm

Pay Oil Co. Company

Newland Contractor

Virgil, North

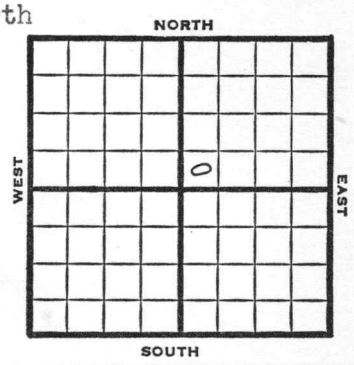

____ Ft. from N. Line

330' Ft. from S. Line

____ Ft. from E. Line

330' Ft. from W. Line

SW SW NE

1950	?	REPORT
6/21	Rig up	
8/16	12" @ 61 6" @ 1600 Miss 1760 4½" @ 1760 2000 A TD 1808 Comp 10 bopd Completed	

COMPLETED

...n 26 200 Bks. 11-49 Petrol Kansas Virgil, North

Map No. ____ Sec. 11 Twp. 23 R. 13E


Well No. 1 Kufahl

Pay Oil Co. Company

Newland Contractor

SW SW NE

SECTION PLAT

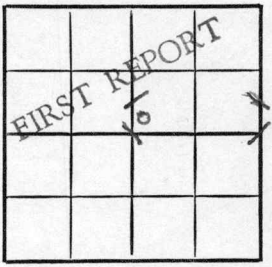

____ Ft. from N. Line

330 Ft. from S. Line

____ Ft. from E. Line

330 Ft. from W. Line

Coffey County

Location ____

Rig up x

Drilling and Remarks:

RECORD

Cased ____ in., ____ ft.

Sand ____

Gas ____

Oil ____

Total Depth ____

PRODUCTION

1st 24 hrs. Nat. ____

1st 24 hrs. after shot ____

Gas ____ Cu. Ft.

Dry Hole ____

Abandoned ____

Date

JUN 21 1950 19 J. E. TYRA Scout

FORM 275 FOR SALE BY KANSAS BLUE PRINT CO.


County Coffey State Kansas

Sec. 11 (Blk. Twp.) 23 (Sur. Rge.) 13E Map No.

Operator Pay Oil Co.

Well No. 1 Farm Kufahl

Elev. Location SW SW NE

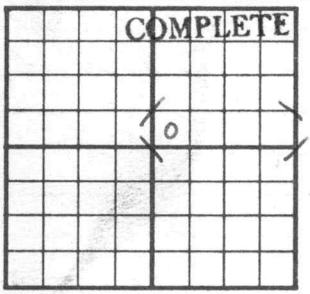

330 Ft. From S Line NE

330 Ft. From W Line Quarter

1st. Report

Completion AUG 1 6 1950

Remarks

North Virgil Pool

Spudding Date

Drlg. Data Oil well TD 1808

12" @ 61 6" @ 1600 Miss. 1760

4½" @ 1760 2000 A TD 1808

Comp. 10 bopd

J. E. TYRA