


Map No. 7 Sec. 10 Twp. 23 R. 13Well No. 4 Young FarmThita Oil Company

N

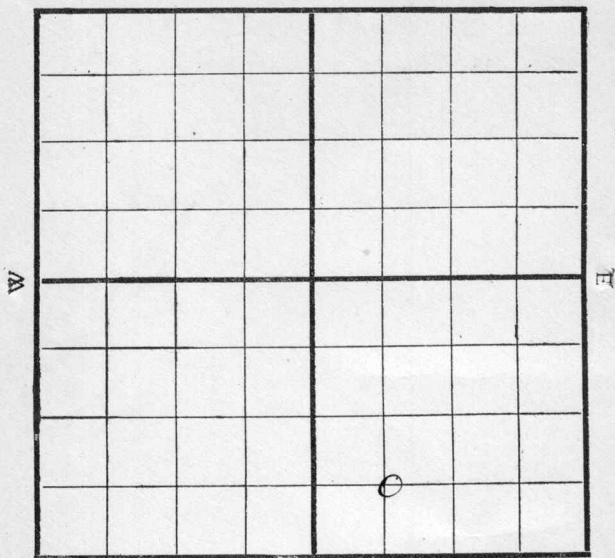

S

Location -----

Drilling Remarks:

RECORD

Cased ----- in. ----- ft.

Sand -----

Gas -----

Oil -----

Total Depth -----

Rig Up -----

Drilling Remarks:

PRODUCTION

1st 24 hrs. Nat. -----

1st 24 hrs. after shot -----

Gas ----- cu. ft.

Dry Hole -----


Abandoned -----

Map No. _____ Sec. 10 Twp. 23 R. 13Well No. 4 Young Farm _____
Theta Oil Company _____

Ft. from N. Line

660 Ft. from S. Line

Ft. from E. Line

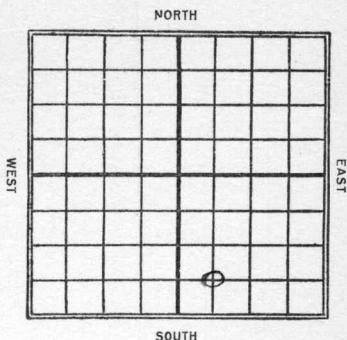
660 Ft. from W. Line

Date

REPORT

192211/15bedg ring2/4Spudding3/26Top line 1788. Sd. 1807-20Shot 60 gts. Pumping 15Bbls.

Map No. R17 Sec. 10 Twp. 23 R. 13
Well No. 4 Young
2 hole oil Company.
660' from S NORTH 660' from W

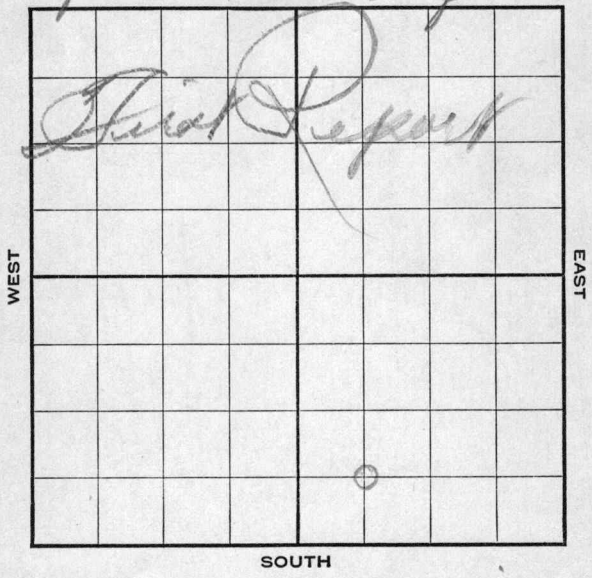

Location _____
Rig up _____
Drilling and Remarks:
Rig Slaty

RECORD
Cased _____ in., _____ ft.
Sand _____
Gas _____
Oil _____
Total Depth _____

PRODUCTION
1st 24 hrs. Nat. _____
1st 24 hrs. after shot _____
Gas _____ Cu. Ft.
Dry Hole _____
Abandoned _____

State Kansas
Date 1/15 1922 Scout W. B.

Map No. K 17 Sec. 10 Twp. 23 R. 13Well No. 4 Young
T. Luta Company

Contractor

COMPLETED SECTION PLAT

Ft. from N. Line

660' Ft. from S. Line

Ft. from E. Line

660' Ft. from W. Line

Location

Rig up

Drilling and Remarks:

Ref. 1738'
sand { 1807'
 { 1820'
shot 60 ft
pumping
15 rbb.

RECORD

Cased _____ in., _____ ft.

Sand _____

Gas _____

Oil _____

Total Depth _____

PRODUCTION

1st 24 hrs. Nat. _____

1st 24 hrs. after shot _____

Gas _____ Cu. Ft.

Dry Hole _____

Abandoned _____

Date

MAR 26 1922

191

M. A. BENEAR

Scout