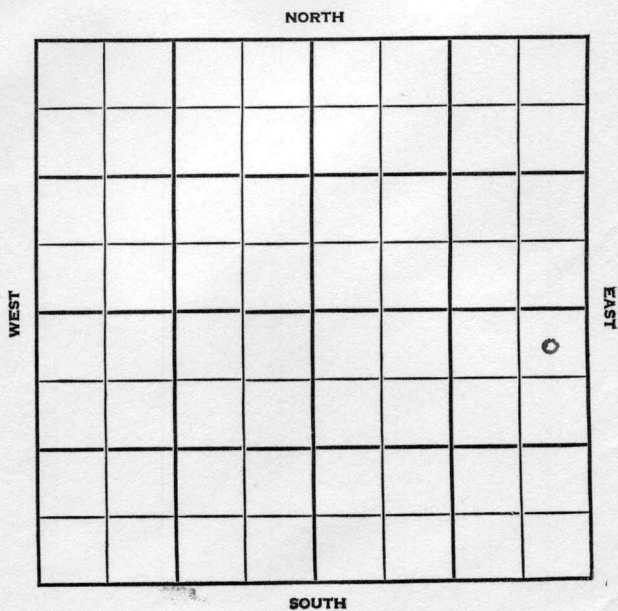


Section 30 Township 28 Range 1EWell No. 2 CoxCompany E. H. Adair

Sedgwick

KANSAS

SEC.	TWP.	R.
30	28	1 E
WELL NO.		
# 2 Cox		FARM
COMPANY		
E. H. Adair		
CONTRACTOR		

Gladys Pool


330 Ft. from N. Line

Ft. from S. Line

330 Ft. from E. Line

Ft. from W. Line

NE NE SE

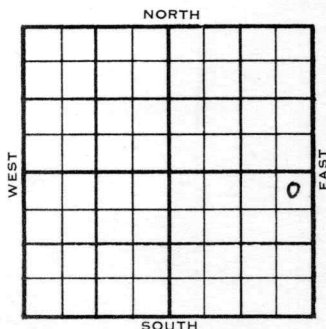

1954

ELEVATION

1269'

REPORT

12/29
1955
1/26

Cellar & Pits

Spud 12-29-54

Oil Well

TD 3142'

8" @ 164'

Lans 2269', Stal. 2281' KC 2622'

B KC 2822' Miss 3130' Miss dolo 3132'

TD 3142'

5" @ 3133'

CO to 3142 S/ 4 boph 1000 A

Comp F. 714 bopd.

COMPLETED

County **Sedgwick** State **Kansas**

Sec. 30 (Blk. 28 (Sur. 1E Map No.

Operator E. H. Adair

Well No. **2** Farm **Cox**

[illegible]

FIRST REPORT 0

330 Ft. From N Line SE

330 Ft. From E Line Quarter

1st. Report DFC ' 9 1954

Completion _____


Remarks

Spudding Date _____

Drlg. Data Gladys Pool

Cellar & pits

FABEN GILSTRAP

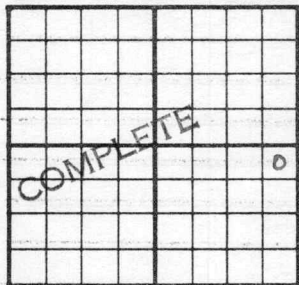County Sedgwick State KansasSec. 30 (Blk.) 28 (Sur.) 1E Map No.Operator E. H. AdairWell No. 2 Farm CoxElev. 1269 Location NE NE SE330 Ft. From N Line SE330 Ft. From E Line Quarter1st. ReportCompletion JAN 26 1955Remarks Gladys PoolCo. toolsSpudding Date 12-29-54Drlg. Data Oil well TD 31428" @ 164 Lens. 2269 Stal. 2281KC 2622 B KC 2822 Miss. 3130Miss. dolo 3132 TD 3142 5" @ 3133CO to 3142 S/ 4 boph 1000 AComp. F/ 714 bopd

FABEN GILSTRAP