
Form 51 5M 2-22 8411 Kansas

Map No. _____ Sec. 10 Twp. 23 R. 13

Well No. 5 Young Farm

Theta Company

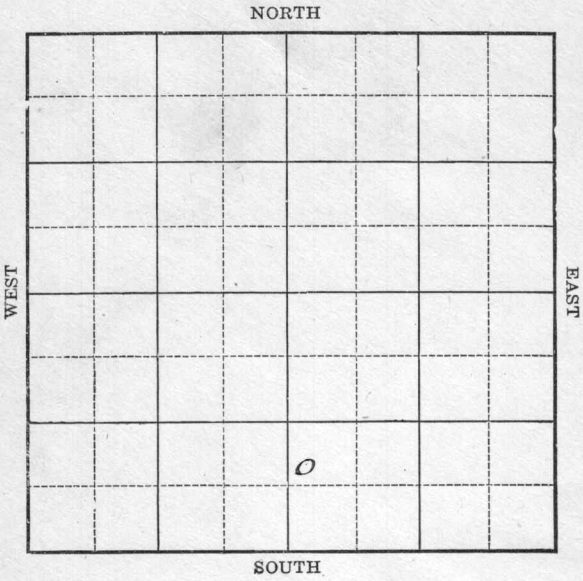

Location _____

Drilling Remarks:

Rig Up _____

Drilling Remarks:

RECORD

Cased _____ in. _____ ft.

Sand _____

Gas _____

Oil _____

Total Depth _____

PRODUCTION

1st 24 hrs. Nat. _____

1st 24 hrs. after shot _____

Gas _____ cu. ft.

Dry Hole _____

Abandoned _____

Form 252A 5M 8-21 PALACE-TULSA 6835

Map No. _____ Sec. 10 Twp. 23 R. 13

Well No. # 5 Young Farm


Theta Company

_____ Ft. from N, Line

810 Ft. from S. Line

_____ Ft. from E. Line

200 Ft. from W. Line

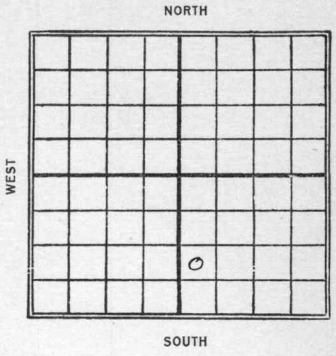

Date 1922	REPORT
5/21	Rig
7/15	1800-1812 Top lime 1781
	60 qts 10 Bbls

Form 26—1M—4-19—Mid-West

Map No. 17 Lane Sec. 10 Twp. 23 R. 13


Well No. 5 Young

T Smith Company

Contractor

FIRST REPORT

SECTION PLAT

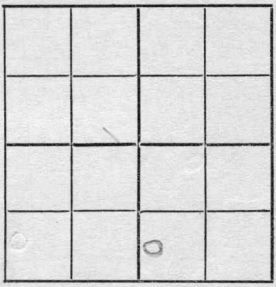

810 Ft. from N. Line

Ft. from S. Line

Ft. from E. Line

200 Ft. from W. Line

Location

Rig up

Drilling and Remarks:

Rig

RECORD

Cased in., ft.

Sand

Gas

Oil

Total Depth

PRODUCTION

1st 24 hrs. Nat.

1st 24 hrs. after shot

Gas Cu. Ft.

Dry Hole

Abandoned

Date

MAY 21 1922

191

M. A. BENEAR

Scout

Form 26—1M—4-19—Mid-West

Map No. Kan 17 Sec. 10 Twp. 23 R. 13


Well No. 5 Young

Chita Company

Contractor

COMPLETED

SECTION PLAT

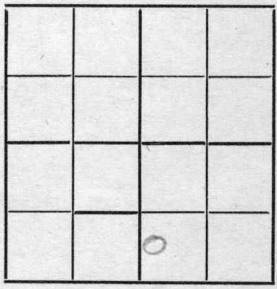

810' Ft. from N. Line

Ft. from S. Line

Ft. from E. Line

200 Ft. from W. Line

Location

Rig up

Drilling and Remarks:

Tap line 1781
6 qts shot

RECORD

Cased in., ft.

Sand

Gas

Oil 1800-1812

Total Depth

PRODUCTION

1st 24 hrs. Nat.

1st 24 hrs. after shot 10

Gas Cu. Ft.

Dry Hole

Abandoned

Date

JUL 15 1922 191

M. A. BENEAR Scout