Form 51-5M 5-37 Petrol


Coffey

KANSAS

Section 11 Township 23 Range 13-E

Well No. 2 Kufahl (Kufhal)

Company Preston Hart

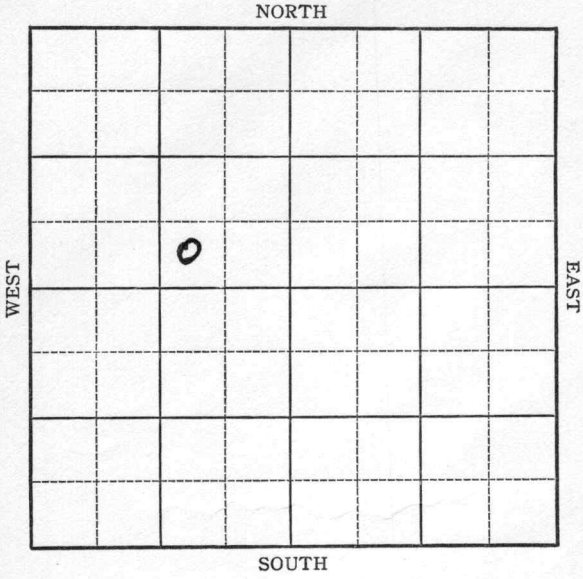


Form 252-A—5M—9-37 KANSAS Coffey

Sec. 11 Twp. 23 R. 13-E

Well No. #2 Kufahl Farm

Preston Hart Company

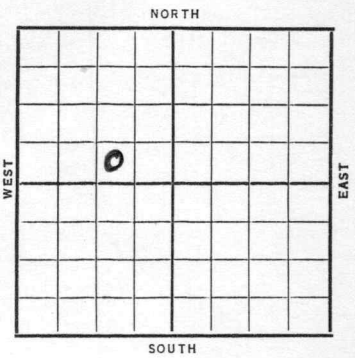

____ Ft. from N. Line

330 Ft. from S. Line

990 Ft. from E. Line

____ Ft. from W. Line

Date	REPORT
1937	
11/10	12" @ 716'. Drlg. 825'.
11/19	" " " "
11/26	Miss. & 6" @ 1769'. T.D. 1812'.
	Shot 50 qts. C.O.
12/1	6" @ 1769'.
	Miss. 1769'.
	T.D. 1812'.
	Shot 50 qts.
	10 bbls.
	COMPLETED

Form 26—1M Bks.—2-29

Coffey KANSAS

Map No. 17M Sec. 11 Twp. 23 R. 13E

Well No. 2 Kufahl

Preston Hart Company

Contractor

FIRST REPORT

SW SE NW


Ft. from N. Line

330 Ft. from S. Line

990 Ft. from E. Line

Ft. from W. Line

SECTION PLAT

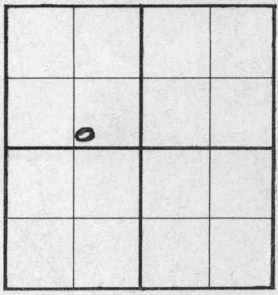

Location

Rig up

Drilling and Remarks:

12"- 716

Dlg. 825

RECORD

Cased in., ft.

Sand

Gas

Oil

Total Depth

PRODUCTION

1st 24 hrs. Nat.

1st 24 hrs. after shot

Gas Cu. Ft.

Dry Hole

Abandoned

Date

NOV 10 1937 19

H. D. Hatfield Scout

Form 26—1M Bks.—2-29

Coffey KANSAS

Map No. 17 M Sec. 11 Twp. 23 R. 13E

Well No. 2 Kufahl

Preston Hart Company

Contractor

COMPLETED

SW SE NW


Ft. from N. Line

330 Ft. from S. Line

990 Ft. from E. Line

Ft. from W. Line

SECTION PLAT

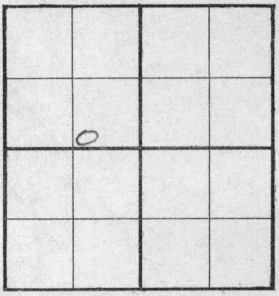

Location

Rig up

Drilling and Remarks:

shot 50 qts

10 bbls

RECORD

Cased 6 in. 1769 ft.

~~Sand~~ Miss 1769

Gas

Oil

Total Depth 1812

PRODUCTION

1st 24 hrs. Nat.

1st 24 hrs. after shot

Gas Cu. Ft.

Dry Hole

Abandoned

Date

DEC 1- 1937 19

H. D. Hatfield Scout