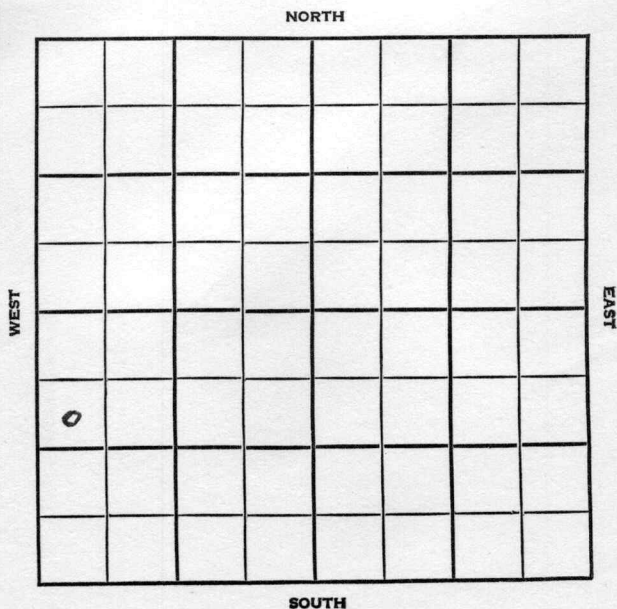


Section 30 Township 28 Range 1EWell No. 2 RichmondCompany Beardmore-Sutton

SEC.	30	TWP.	28	R.	1 E
WELL NO.					
# 2 Richmond					FARM
COMPANY					
Beardmore-Sutton					
CONTRACTOR					


990 _____ Ft. from N. Line

Ft. from S. Line

Ft. from E. Line

330 Ft. from W. Line

SW NW SW

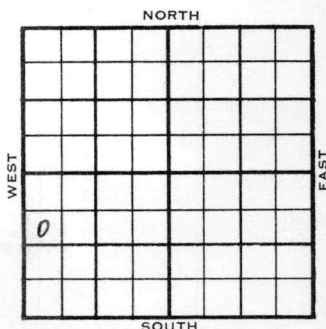

ELEVATION		REPORT
1954	1271'	
12/22	MIM	
1955		
1/26	Spud 12-21-54	
	Oil Well	
	TD 3190'	
	8" @ 128'	
	EroMiss 3140' Dolo 3146'	
	TD 3180'	
	5" @ 3172'	
	DD 3185'	
	S/ 4 boph 4 hr. DD 3190'	
	S/ 5 $\frac{1}{2}$ boph 8 hr.	
	1000 A F/ 8 boph 8 hr.	
	Comp F/ 358 bopd.	
		COMPLETED

DX-78

County **Sedgwick** State **Kansas**

Sec. 30 (Blk.) 28 (Sur.) 1E Map No.

Operator **Beardmore-Sutton**

Well No. **2** Farm **Richmond**

Elev.	Location	SW	NW	SW
			FIRST	REPORT			
O							

990 Ft. From N Line SW

330 Ft. From **W** Line Quarter

1st. Report DEC 22 1954

Completion

Remarks

Spudding Date _____

Drlg. Data Gladys Pool

M I M

FABEN GILSTRAP

County Sedgwick State Kansas
 Sec. 30 (Blk.) 28 (Sur.) 1E Map No. _____
 Operator Beardmore-Sutton
 Well No. 2 Farm Richmond
 Elev. 1271 Location SW NW SW

990 Ft. From N Line SW
 330 Ft. From W Line Quarter

1st. Report _____

Completion JAN 26 1955

Remarks Gladys Pool

Spudding Date 12-21-54

Drlg. Data Oil well TD 3190
8" @ 128 EroMiss. 3140 Dolo 3146
TD 3180 5" @ 3172 DD 3185 S/ 4 boph
4 hr. DD 3190 S/ 5 $\frac{1}{2}$ boph 8 hr.
1000 A F/ 8 boph 8 hr.
Comp. F/ 358 bopd

FABEN GILSTRAP