
FORM 51 25M 3-49 PETROL Greenwood KANSAS

Section 10 Township 23 Range 13E

Well No. #1 Young

Company White & Ellis

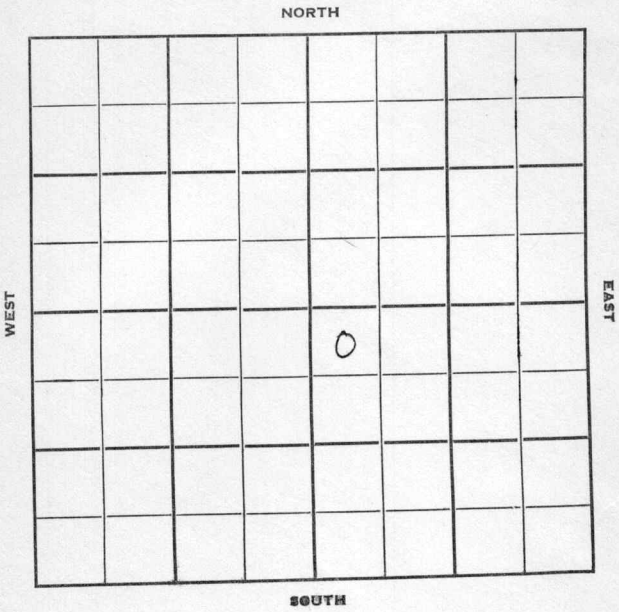

FORM 252-B
10M 9-49 PETROL

Greenwood KANSAS

Sec. 10 Twp. 23 R. 13E

Well No. #1 Young Farm

White & Ellis Company

Contractor

Miscellaneous


~~330'~~ Ft. from N. Line

330 Ft. from S. Line

_____ Ft. from E. Line

330' Ft. from W. Line

~~NW NW SE~~
SW SW NE

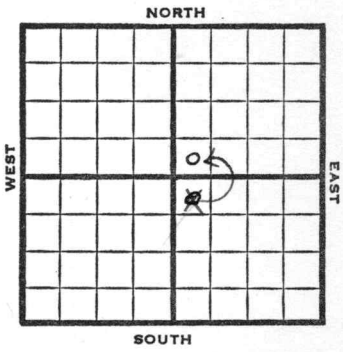

1950	Elev	REPORT
5/3	Location	
5/17	TD 1810	
	8" @ 20	
	Miss 1776	
	5" @ 1798	
	20 BOPD	
	Completed	
	COMPLETED	

Form 26 200 Bks. 11-49 Petrol

Kansas Miscellaneous

Map No. _____ Sec. 10 Twp. 23 R. 13E

Well No. 1 Young

White & Ellis Company

Contractor

NW NW SE

330 Ft. from N. Line

_____ Ft. from S. Line

_____ Ft. from E. Line

330 Ft. from W. Line

Greenwood County

SECTION PLAT



Location x

Rig up _____

Drilling and Remarks:

RECORD

Cased _____ in., _____ ft.

Sand _____

Gas _____

Oil _____

Total Depth _____

PRODUCTION

1st 24 hrs. Nat. _____

1st 24 hrs. after shot _____

Gas _____ Cu. Ft.

Dry Hole _____

Abandoned _____

Date

MAY 3 1950 19 J. E. TYRA Scout

Form 26 200 Bks. 11-49 Petrol Kansas Miscellaneous

Map No. _____ Sec. 10 Twp. 23 R. 13E


Well No. 1 Young

White & Ellis Company

Contractor

NW NW SE

SECTION PLAT

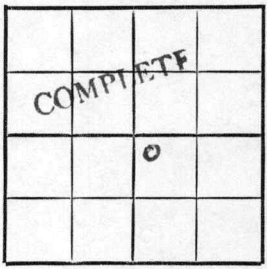

330 Ft. from N. Line

Ft. from S. Line

Ft. from E. Line

330 Ft. from W. Line

Greenwood

Location

Rig up

Drilling and Remarks:

8" @ 20'
Miss 1776
5" @ 1798
20 BOPD

RECORD

Cased _____ in., _____ ft.

Sand

Gas

Oil

Total Depth 1810

PRODUCTION

1st 24 hrs. Nat.

1st 24 hrs. after shot

Gas Cu. Ft.

Dry Hole

Abandoned

Date

MAY 17 1950 19

J. E. TYRA Scout

Form 26 200 Bks. 11-49 Petrol

Kansas

Map No. _____ Sec. 10 Twp. 23 R. 13E

Well No. 1 Young


White & Ellis Company

CORRECTION

_____ Contractor

SW SW NE

SECTION PLAT

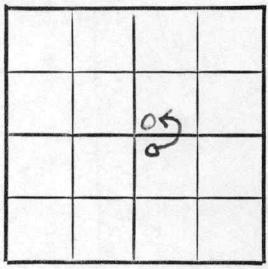

_____ Ft. from N. Line

330 Ft. from S. Line

_____ Ft. from E. Line

330 Ft. from W. Line

Greenwood County

Location _____

Rig up _____

Drilling and Remarks:

Completed
5-17-50
NW NW SE

RECORD

Cased _____ in., _____ ft.
Sand _____
Gas _____
Oil _____
Total Depth _____

PRODUCTION

1st 24 hrs. Nat. _____
1st 24 hrs. after shot _____
Gas _____ Cu. Ft.
Dry Hole _____
Abandoned _____

Date

NOV 1 1950 19 J. E. TYRA Scout